


Well No. # 1 Motter

Company Miller

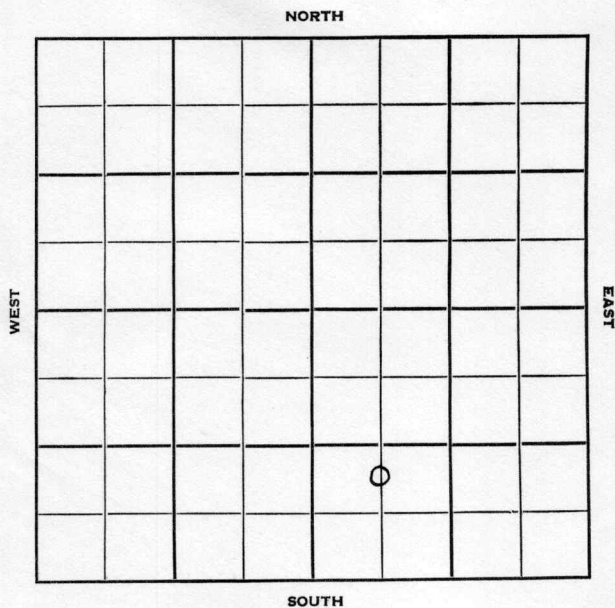

Woodson

KANSAS

Sec. 31 Twp. 23 R. 16E

Well No. #1 Motter Farm

Miller Company

Contractor


 Ft. from N. Line

990' Ft. from S. Line

 Ft. from E. Line

660' Ft. from W. Line

C N L SW SE

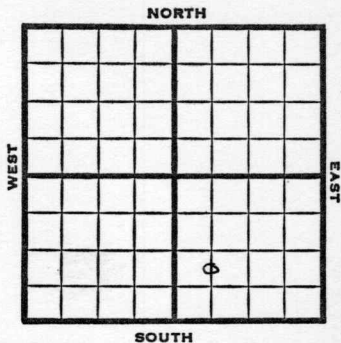

1951

Elev. -

REPORT

3/28

Spud 3-21-51
Drlg. 640'

4/18

Spud 3-21-51
D&A TD 1510
8" @ 755'
Miss 1486
TD 1510
D&A

ABANDONED

County Woodson State Kansas
 Sec. 31 (Blk.) 23 (Sur.) 16E 1132
 (Twp.) (Rge.) Map No.

Operator Miller

Well No. 1 Farm Motter

Elev. _____ Location C N L SW SE 100' SE

990 Ft. From S of abd. well SE
 Line

660 Ft. From W Line Quarter

Ist. Report MAR 28 1951

Completion _____

Remarks _____

Spudding Date 3-21-51

Drlg. Data _____

drlg. 640

J. E. TYRA

County Woodson State Kansas
 Sec. 31 (Blk. 23 (Sur. 16E Map No.
 (Twp.) Rge.)

Operator Miller

Well No. 1 Farm Motter

Elev. Location C N L SW SE



990 Ft. From S Line SE

660 Ft. From W Line Quarter

1st. Report

Completion APR 18 1951

Remarks

Spudding Date 3-21-51

Drig. Data D & A TD 1510

8" @ 755 Miss. 1486 TD 1510

D & A

J. E. TYRA