

Map No. 31 Sec. 23 Twp. 16 R. 16
Well No. Southwick Farm
Purch hill et al Company

NORTH

[illegible]

SOUTH

Location.....

Drilling Remarks

Rig Up.....

Drilling Remarks

RECORD

Cased.....in.....ft.

Sand_____

Gas.....

Oil_____

Total Depth.....

PRODUCTION

1st 24 hrs. Nat.....

1st 24 hrs. after shot.....


Gas.....cu. ft.....

Dry Hole.....

Abandoned.....

Well No. 1- Southwick Farm
Church Hill et al Company

250 Ft. from W. Line

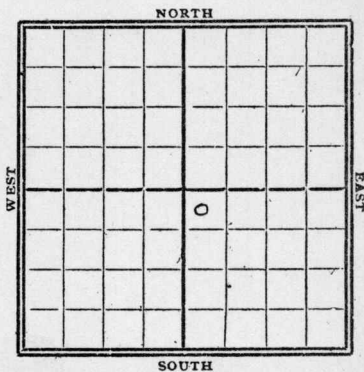

1928

Date	REPORT
12/19	Top line 1467'
	Top sand 1481'
	VIR 6"
12/26	—
1929	
1/2	—
1/9	Top line 1467'
	sand 1481'-92'
	T.D. 1492'
	3.5 bbls oil
	28 gravity
	Completed

Woodson

KANSAS
 Map No. _____ Sec. 31 Twp. 23 R. 16
 No Map
 Well No. Southwick
Churchill et al Company

Contractor

FIRST REPORTS

SECTION PLAT

		0	

750 Ft. from N. Line

_____ Ft. from S. Line

_____ Ft. from E. Line

750 Ft. from W. Line

Location _____

Rig up _____

Drilling and Remarks:

Top line 1467'
 Top Sand 1481'
 U/R 6"

RECORD

Cased _____ in., _____ ft.

Sand _____

Gas _____

Oil _____

Total Depth _____

PRODUCTION

1st 24 hrs. Nat. _____

1st 24 hrs. after shot _____

Gas _____ Cu. Ft.

Dry Hole _____

Abandoned _____

Date

DEC 19 1928

CHAS. L. SHERWOOD

192

Scout

KANSAS

Map No. *Woodson* Sec. *31* Twp. *23* R. *16*Well No. *1* *Southwick**Churchill & al*

Company

Contractor

COMPLETED

SECTION PLAT

		0	

250 Ft. from N. Line

Ft. from S. Line

Ft. from E. Line

250 Ft. from W. Line

Location

Rig up

Drilling and Remarks:

*Top line 1467**35 Bbs.**28 Gravity*

RECORD

Cased _____ in., _____ ft.

Sand *1481-1492*

Gas _____

Oil _____

Total Depth *1492*

PRODUCTION

1st 24 hrs. Nat. _____

1st 24 hrs. after shot _____

Gas _____ Cu. Ft.

Dry Hole _____

Abandoned _____

Date

JAN. 9 1929

CHAS. L. SHERWOOD

192

Scout