


Map No. _____ Sec. 2 Twp. 24 R. 11
Well No. 1-Parks Farm _____
Simmons & Rhodes Company

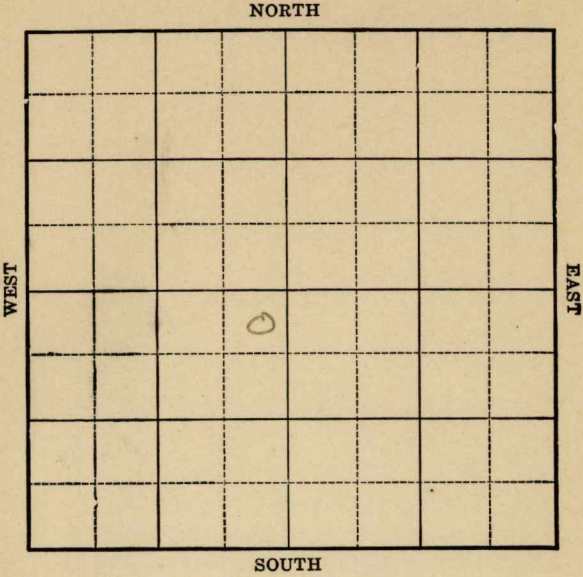

Location _____
Drilling Remarks _____

Rig Up _____
Drilling Remarks _____

RECORD

Cased _____ in. _____ ft.
Sand _____
Gas _____
Oil _____
Total Depth _____

PRODUCTION

1st 24 hrs. Nat. _____
1st 24 hrs. after shot _____
Gas _____ cu. ft.
Dry Hole _____
Abandoned _____

Kansas

Map No. _____ Sec. *2* Twp. *24* R. *11*

Well No. *1-Parks* Farm _____

Simmons-Rhodes Company


NORTH

330 Ft. from N. Line

_____ Ft. from S. Line

330 Ft. from E. Line

_____ Ft. from W. Line

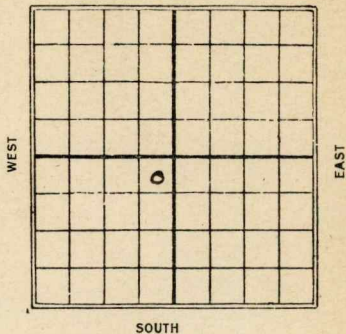

1927

Date

REPORT

<i>2/24</i>	<i>Location</i>
<i>3/2</i>	<i>—</i>
<i>3/9</i>	<i>—</i>
<i>3/16</i>	<i>—</i>
<i>3/24</i>	<i>—</i>
<i>3/30</i>	<i>—</i>
<i>4/7</i>	<i>—</i>
<i>4/13</i>	<i>—</i>
<i>4/20</i>	<i>—</i>
<i>4/27</i>	<i>—</i>
<i>5/5</i>	<i>—</i>
<i>5/12</i>	<i>—</i>
<i>5/18</i>	<i>—</i>
<i>5/25</i>	<i>—</i>
<i>6/1</i>	<i>—</i>
<i>6/7</i>	<i>—</i>
<i>6/15</i>	<i>—</i>
<i>6/22</i>	<i>—</i>
<i>6/29</i>	<i>—</i>
<i>7/7</i>	<i>—</i>
<i>7/13</i>	<i>—</i>
<i>7/20</i>	<i>—</i>

7/28 - aband. Loc.

Greenwood E
 16 **KANSAS** 2 24 11
 Map No. Sec. Twp. R.
 Well No. 1 *K.A.*
Simmons & Rhodes Company

Contractor

FIRST REPORTS**SECTION PLAT**

330 Ft. from N. Line

Ft. from S. Line

330 Ft. from E. Line

Ft. from W. Line

	o		

Location ✓

Rig up

Drilling and Remarks:

RECORD

Cased _____ in., _____ ft.

Sand _____

Gas _____

Oil _____

Total Depth _____

PRODUCTION

1st 24 hrs. Nat. _____

1st 24 hrs. after shot _____

Gas _____ Cu. Ft.

Dry Hole _____

Abandoned _____

Date

FEB 24 1927

CHAS. L. SHERWOOD

192

Scout

16 **KANSAS** *2* *24* *11*
 Map No. _____ Sec. _____ Twp. _____ R. _____
 Well No. *1* *farks* _____
Simmons & Rhodes Company

Contractor _____

COMPLETED**SECTION PLAT***330*

Ft. from N. Line

Ft. from S. Line

330

Ft. from E. Line

Ft. from W. Line

ABANDONED

Location _____

Rig up _____

Drilling and Remarks:

RECORD

Cased _____ in., _____ ft.

Sand _____

Gas _____

Oil _____

Total Depth _____

PRODUCTION

1st 24 hrs. Nat. _____

1st 24 hrs. after shot _____

Gas _____ Cu. Ft.

Dry Hole _____

Abandoned _____

Date

Abd *Location*
JUL 28 1927**CHAS. L. SHERWOOD**

192

Scout