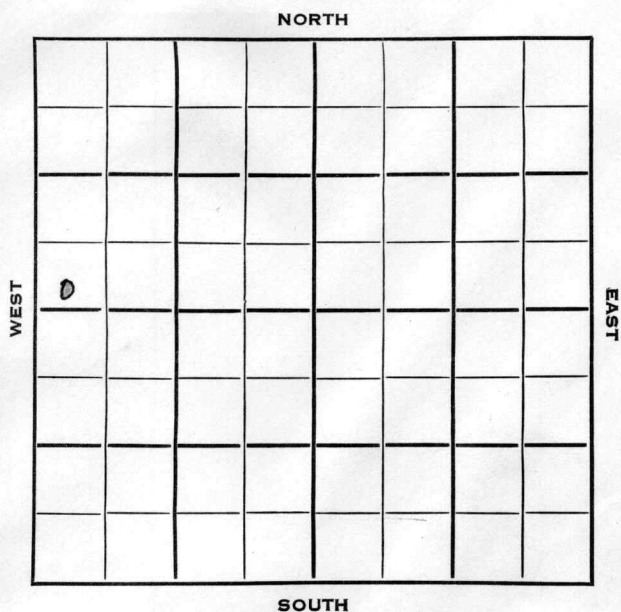


Section 9 Township 24 Range 1EWell No. 1 GronauCompany Trans-Era

Harvey

KANSAS ✓

Sec. 9 Twp. 24 R. 1EWell No. 1 Gronau Farm

Trans-Era Company

Trans-Era Contractor

Wildcat

Ft. from N. Line

330


Ft. from S. Line

Ft. from E. Line

330

Ft. from W. Line

SW SW NW

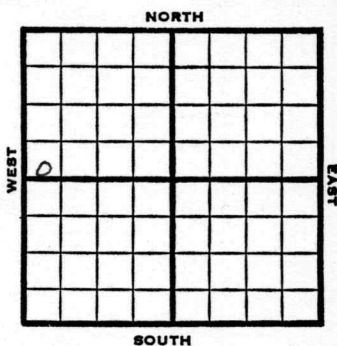

1952

Elev. 1451'

REPORT

12/30

Set Surface

1953

2/25

Spud 2-6-53

D&A

TD 3655

8" @ 203

Lans 2355, KC 2546, Cong 2989,

Miss 3040, Hunton 3443, Viola

3535, Simp 3547, Arb 3629

TD 3655

DST 3558-71, opn 1 hr., rec.

20' mud, 420' wtr., 1275#

D&A

ABANDONED

County **Harvey** State **Kansas**Sec. **9** (Blk.) **24** (Sur.) **1E** Map No.Operator **Trans-Era**Well No. **1** Farm **Gronau**Elev. Location **SW SW NW**

0							

FIRST REPORT

330 Ft. From **S** Line **NW****330** Ft. From **W** Line Quarter1st. Report **DEC 30 1952**

Completion


Remarks

Trans-Era - Contr.

Spudding Date

Drlg. Data **Wildcat****set surface**

County Harvey State Kansas
 Sec. 9 (Blk.) 24 (Sur.) 1E Map No.
 Operator Trans-Era
 Well No. 1 Farm Gronau
 Elev. 1451 Location SW SW NW

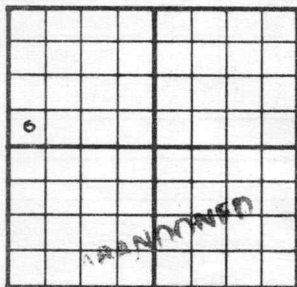

330 Ft. From S Line NW

330 Ft. From W Line Quarter

1st. Report

Completion FEB 25 1953

Remarks Wildcat

Trans-Era - Contr.

Spudding Date 2-6-53

Drilg. Data D & A TD 3655

8" @ 203 Lans. 2355 KC 2546

Cong. 2989 Miss. 3040 Hunton 3443

Viola 3535 Simp. 3547 Arb. 3629

TD 3655 DST 3558-71 open 1 hr.

Rec. 20' mud 420' wtr. 1275#

D & A