

Map No. 25 Sec. 27 Twp. 24 R. 9
Well No. 1-11 Hell Farm
~~Hontague et al~~ Company
Seeward Pet Co
NORTH

WEST

EAST

SOUTH

0

Location _____

Drilling Remarks:

Rig up _____

Drilling Remarks:

RECORD

Cased _____ in. _____ ft.

Sand _____

Gas _____

Oil _____

Total Depth_____

PRODUCTION

1st 24 hrs Nat. _____

1st 24 hrs. after shot_____

Gas _____ cu. ft.

Dry Hole_____


Abandoned _____

Map No. JK Sec. 27 Twp. 24 R. 9Well No. 1-Heel Farm
~~Fontaine Shark~~ Company
Seeward Pet Co

Ft. from N. Line

1120 Ft. from S. Line200 Ft. from E. Line

Ft. from W. Line

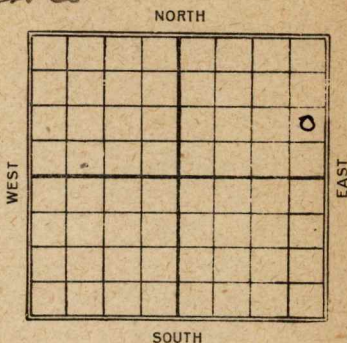

Date

REPORT

1921	
6/10	Rug up
7/16	- 600'
10/28	- S. 2148-2200 Fishing Pipe
11/26	_____
12/17	_____
1925	_____
1/21	_____
5/28	S.D. 2200
6/5	_____
6/12	_____
6/19	S. 2148-2200 & S.D.
6/26	_____
7/3	_____
7/10	S. 2148-2200' S.D.
7/17	_____
7/24	_____
7/31	_____
8/7	_____
8/14	_____
8/20	_____
8/27	_____
9/3	_____

9/11 S.H. @ 2200'

9/16 _____

9/24 _____

10/1 _____

10/8 _____

10/16 _____

10/22 _____

10/29 _____

11/13- Abandoned 2200

15
Map No. **KANSAS** Sec. 27 Twp. 24 R. 9
Well No. 1-18-11
Fontaine et al Company
Contractor

FIRST REPORT SECTION PLAT

_____ Ft. from N. Line
1120 Ft. from S. Line
200 Ft. from E. Line
_____ Ft. from W. Line

			0

Location _____
Rig up ✓
Drilling and Remarks:

RECORD
Cased _____ in., _____ ft.
Sand _____
Gas _____
Oil _____
Total Depth _____

PRODUCTION
1st 24 hrs. Nat. _____
1st 24 hrs. after shot _____
Gas _____ Cu. Ft.
Dry Hole _____
Abandoned _____

Date JUN 10 1924
192 Scout

M. A. BENEAR

K 15
 Map No. **KANSAS** Sec. *27* Twp. *24* R. *9*
 Well No. *"14" Hill*
Sheward *Let Co* Company

Contractor

FIRST REPORTS

SECTION PLAT

Ft. from N. Line

1120

Ft. from S. Line

200

Ft. from E. Line

Ft. from W. Line

Formerly owned by
Fontaine et al

Thin to #1 well

		✓	○
		✓	✓

Location ✓

Rig up

Drilling and Remarks:

RECORD

Cased _____ in., _____ ft.

Sand _____

Gas _____

Oil _____

Total Depth _____

PRODUCTION

1st 24 hrs. Nat. _____

1st 24 hrs. after shot _____

Gas _____ Cu. Ft.

Dry Hole _____

Abandoned _____

Date

NOV 13 1925

CHAS. L. SHERWOOD

192

Scout

Map No. *15* **ANSAS** Sec. *27* Twp. *24* R. *9*
 Well No. *1 "H"* *Hill*
Leeward *pet Co* Company

Wm to #1 Contractor

SECTION PLAT

		✓	o
		✓	✓

_____ Ft. from N. Line

1120 _____ Ft. from S. Line

200 _____ Ft. from E. Line

_____ Ft. from W. Line

CORRECTION

Location ☒ _____

Rig up _____

Drilling and Remarks:

chg ownership
from Fontaine
et al to above.

RECORD

Cased _____ in., _____ ft.

Sand _____

Gas _____

Oil _____

Total Depth _____

PRODUCTION

1st 24 hrs. Nat. _____

1st 24 hrs. after shot _____

Gas _____ Cu. Ft.

Dry Hole _____

Abandoned _____

Date

NOV 13 1925

192

CHAS. L. SHERWOOD

Scout

Map No. *K15* **KANSAS** Sec. *27* Twp. *24* R. *9*

Well No. *1 Hill*

Fountain et HL Company

Contractor

COMPLETED

SECTION PLAT


_____ Ft. from N. Line

1120 _____ Ft. from S. Line

200 _____ Ft. from E. Line

_____ Ft. from W. Line

ABANDONED

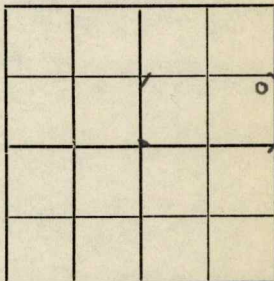

Location _____

Rig up _____

Drilling and Remarks:

*Abandoned on
acct Fishing
Job.*

RECORD

Cased _____ in., _____ ft.

Sand *2148-2200*

Gas _____

Oil _____

Total Depth *2200'*

PRODUCTION

1st 24 hrs. Nat. _____

1st 24 hrs. after shot _____

Gas _____ Cu. Ft.

Dry Hole _____

Abandoned ☒

Date

NOV 13 1925

CHAS. L. SHERWOOD

192

Scout