


11E-K6S
~~1E~~ DRL

SECTION 6 TOWNSHIP 24 RANGE 1E

WELL NO. #21 Kipfer

COMPANY Ward McGinnis

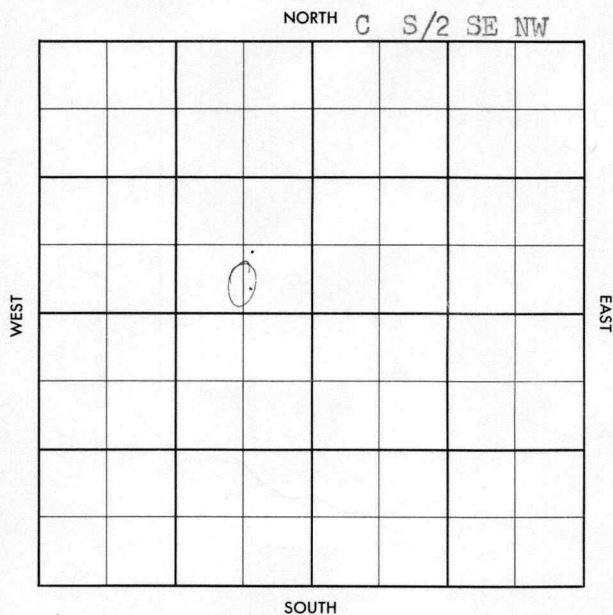

Greenwood *6-24-11E*
~~*Harvey Co.*~~
 County Greenwood Elev. _____
 Sec. 6 Twp. 24 Rgs. 11E
 Company Ward McGinnis
 Farm Name Kipfer No. 21

TOPS	DEPTH	LOG	DATUM	Loc. in Sec.
Anh.				C S/2 SE NW
Tp.				
H.				
Tr.				
Dg.				
Bl.				
L. catl sd	1850			Geol.
K.C.				Contr.
B.K.C.				Co. Tools
Ce.				Pool
C. Btvl	1932			Gaffney
M.				
M.				
K.				
Mz.				
Mq.				
V.				
S.				
S.				
A.				
R.				
Pf.				
G.				
T.D. RTD	2010			

Date Comm. Feb. 1957

D & A

FIRST REPORT
 0
 COMPLETE
 MAR 27 '57

6-24-11E

Greenwood

Our maps show 24S-1E in Harvey County,
and 24S-1E in Greenwood County.
Please advise.

No. 51

Thanks,

Sam Baird

Reported wrong.
6-24-11E


Date Comm. Feb. 1957

D & A