


Map No. 144 Sec. 27 Twp. 24 R. 9

Well No. *3 Wiggins* Farm

Polkarnus et al Company

NORTH

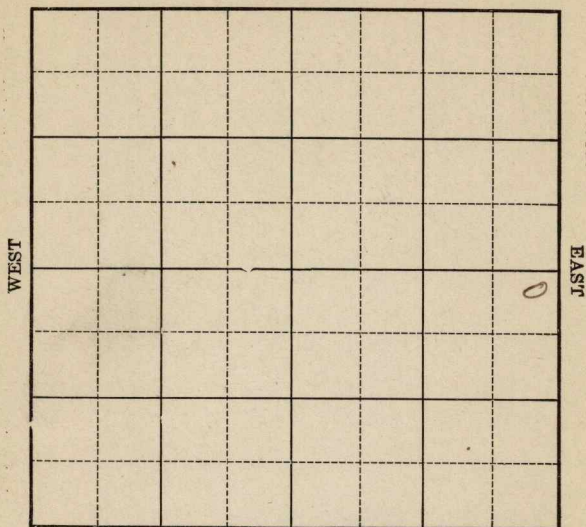

Location

Drilling Remarks

Rig Up

Drilling Remarks

RECORD

Cased_____in. _____ft.

Sand

Gas

Oil _____

Total Depth _____

PRODUCTION

1st 24 hrs. Nat.-----

1st 24 hrs. after shot -----

Gas_____cu. ft.

Dry Hole

Abandoned

K15 *Shenwood Co*Map No. *KANSAS* Sec. *27* Twp. *24* R. *9*Well No. *3 Wiggins**Holzkner et al* Company

Contractor

FIRST REPORTS

SECTION PLAT

250 Ft. from N. Line

Ft. from S. Line

250 Ft. from E. Line

Ft. from W. Line

			G

Location

Rig up ☒

Drilling and Remarks:

RECORD

Cased _____ in., _____ ft.

Sand _____

Gas _____

Oil _____

Total Depth _____

PRODUCTION

1st 24 hrs. Nat. _____

1st 24 hrs. after shot _____

Gas _____ Cu. Ft.

Dry Hole _____

Abandoned _____

Date

OCT 8 1925

192

CHAS. L. SHERWOOD

Scout

Greenwood Co
 Map No. KANSAS 1527 Sec. 24 Twp. 24 R. 9
 Well No. 3 Wiggins
Polkhamus et al Company

Contractor

COMPLETED

SECTION PLAT

250

Ft. from N. Line

Ft. from S. Line

250

Ft. from E. Line

Ft. from W. Line

			o

Location

Rig up

Drilling and Remarks:

RECORD

Cased _____ in., _____ ft.

Sand 2123-2188

Gas _____

Oil _____

Total Depth 2188

PRODUCTION

1st 24 hrs. Nat. _____

1st 24 hrs. after shot _____

Gas _____ Cu. Ft.

Dry Hole _____

Abandoned _____

Date

DEC 3 1925

CHAS. L. SHERWOOD

192

Scout

1607 15 bhs.
 some water.