


Map No. *KANSAS* Sec. *29* Twp. *24* R. *1E*
 Well No. *#1- Buller* Farm
D. R. Luck Company

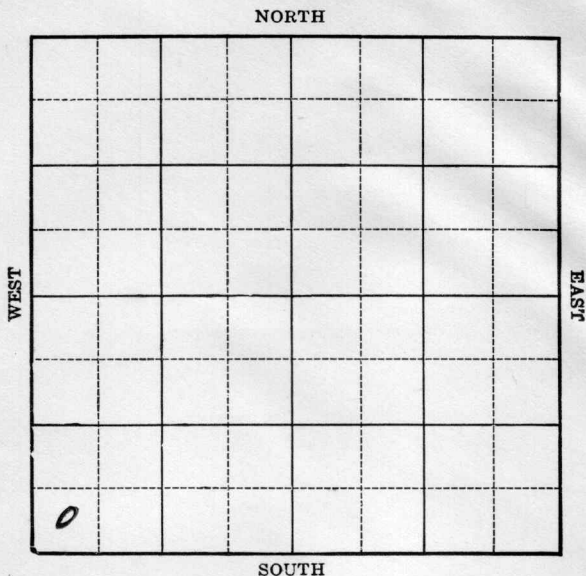

Location _____

Drilling Remarks _____

RECORD

Cased _____ in. _____ ft.

Sand _____

Gas _____

Oil _____

Total Depth _____

Rig Up _____

Drilling Remarks _____

PRODUCTION

1st 24 hrs. Nat. _____

1st 24 hrs. after shot _____

Gas _____ cu. ft. _____


Dry Hole _____

Abandoned _____

Harvey

Map No. KANSAS Sec. 29 Twp. 24 R. 1E
Well No. 1- Boller Farm
D. R. Lauck Company

 Ft. from N. Line
330 Ft. from S. Line
 Ft. from E. Line
330 Ft. from W. Line

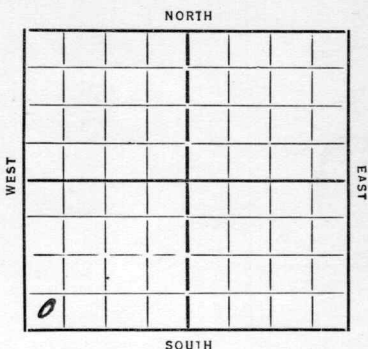

Date 1935 REPORT

4/10 Bldg
4/18 Rig
4/24 dly 1630 20" 101
5/2
5/9 12" 1798 HFW 1780-90
dly 2000
5/16 2 1/4" run 10"
5/22 dly 2622 KC 2344
5/29 " 3013 10" 2815
6/6 U R 8" 3068 TML 3068
HFW 3090 dly 3016
6/13 dly 3417
6/20 BML 3429 Viola 3503
HFW 3505 HFW 3536-40
6" 3561 dly 3599
6/26 Sil 3683 T 7 3683

ABANDONED

Map No. 13 Sec. 29 Twp. 24 R. 1 E

Well No. 1 - Border

D. R. Lank Company

Contractor

FIRST REPORTS

SECTION PLAT

0			

Ft. from N. Line

330 Ft. from S. Line

Ft. from E. Line

330 Ft. from W. Line

Location

Rig up

Drilling and Remarks:

RECORD

Cased in., ft.

Sand

Gas

Oil

Total Depth

PRODUCTION

1st 24 hrs. Nat.

1st 24 hrs. after shot

Gas Cu. Ft.

Dry Hole

Abandoned

Date

ORVAL MANNSCHRECK

4-10-35 192 Scout

Map No. 137 Sec. 29 Twp. 24 R. 1E

Well No. 1 Boiler

D. R. Sauck Company

Contractor

SECTION PLAT

0			

Ft. from N. Line

330 Ft. from S. Line

Ft. from E. Line

330 Ft. from W. Line

ABANDONED

Location

Rig up

Drilling and Remarks:

Oil 3471

RECORD

Cased in., ft.

Sand

Gas

Oil

Total Depth 868.2

PRODUCTION

1st 24 hrs. Nat.

1st 24 hrs. after shot

Gas Cu. Ft.

Dry Hole

Abandoned

Date

6/26/35 192 Scout

ORVAL MANNSCHRECK