


Harvey

KANSAS

SECTION 12 TOWNSHIP 24S RANGE 2E

WELL NO. #1 Roth

COMPANY O.A. Sutton

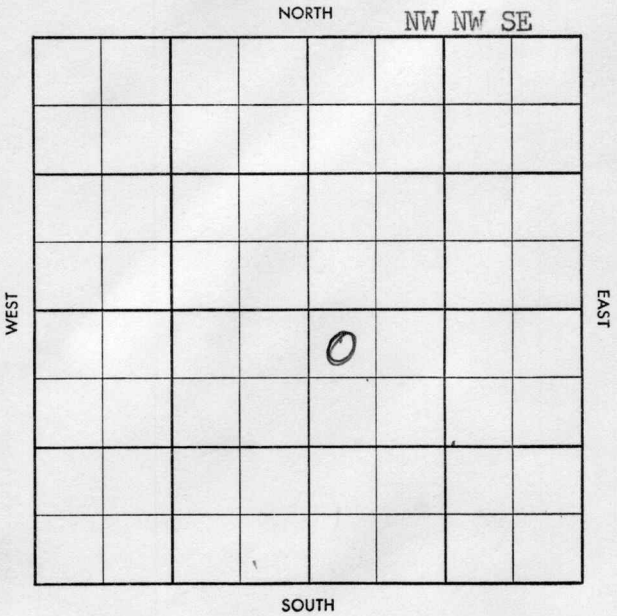

WILDCAT

S-513-B

County Harvey Elev. 1357KB
 Sec. 12 Twp. 24 Rge. 2E
 Company O. A. Sutton
 Farm Name Roth No. 1

TOPS	DEPTH	LOG	DATUM
Anh.			
Tp.			
H.			
Tr.			
Dg.			
B.L.			
L.			
K.C.			
B.K.C.			
Ce.			
C.			
M.			
M.			
K.			
Mz.			
Mq.			
V.			
S.			
S.			
A.			
R.			
Pf.			
G.			
T.D.			

Loc. in Sec. _____


NW NW SE

Geol. Grant

Contr. _____

Pool _____

Wildcat

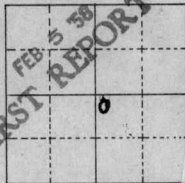

Date Comm. 1/27/58

8" @ 175 w/125, Drlg. 2888

S-513-B

County Harvey Elev. 1357KB 6354DF
 Sec. 12 Twp. 24 Rge. 2E
 Company O. A. Sutton
 Farm Name Roth No. 1


TOPS	DEPTH	LOG	DATUM
Anh.			
Tp.			
H.			
Tr.			
Dg.			
B.L.			
L.		<u>2095</u>	
K.C.		<u>2304</u>	
B.K.C.		<u>2486</u>	
Ce. <u>Burgess</u>		<u>2732</u>	
C.		<u>2747</u>	
M.		<u>2763</u>	
M.			
K.		<u>2993</u>	
Mz. <u>Hunt</u>		<u>3092</u>	
Mq.		<u>3146</u>	
V.		<u>3160</u>	
S.		<u>3189</u>	
S.			
A.		<u>3270</u>	
R.			
Pt.			
G.			
T.D.	<u>3282</u>		

Loc. in Sec.

NW NW SEGeol. Grant

Contr.

Pool

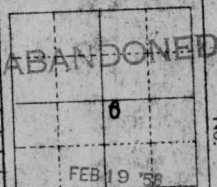WildcatDate Comm. 1/27/58

8" @ 175 w/125, Drlg. 2888 FEB 12 58 FEB 18 58

PST 3228 - 47 60" 15' M BHP
1230/40

DBA