
Harvey KANSAS

SECTION 20 TOWNSHIP 24 RANGE 2E

WELL NO. #1 Voth

COMPANY Adair

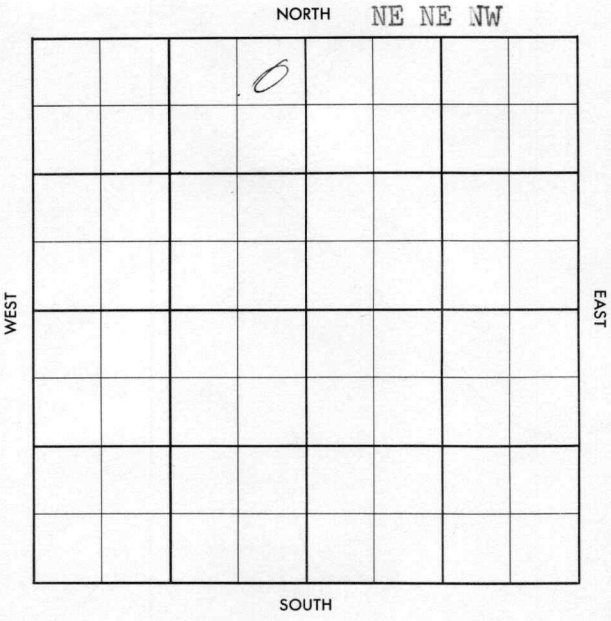

FORM 504-3 SUNRAY

FORM 513 SUNRAY

County Harvey Elev. Co.

Sec. 20 Twp. 24 Rge. 2E

Company Adair

Farm Name Voth No. 1

TOPS	DEPTH	LOG	DATUM
Anh.			
Tp.			
H.			
Tr.			
Dg.			
B.L.			
L.			
K.C.			
B.K.C.			
Ce.			
C.			
M.			
M.			
K.			
Mz.			
Mo.			
V.			
S.			
S.			
A			
R.			
P€.			
G.			
T.D.			

Loc. in Sec. NE NE NW

Geol.

Contr. Co. tools

Pool Gingrass Ext.

0

MAY 22 '57

FIRST REPORT

Date Comm. M I R

FORM 513 SUNRAY

County Harvey Elev. 1428

Sec. 20 Twp. 24 Rge. 2E

Company Adair

FarmName Voth No. 1

TOPS	DEPTH	LOG	DATUM
Anh.			
Tp.			
H.			
Tr.			
Dg.			
Bl.			
L.	2154		
K.C.			
B.K.C.	2648		
Ce. Berg	2904		
C.			
M. Li	2949		
M.			
K.	3217		
Mz.	3292		
Mo. Hunt	3298		
V.			
S.			
S.			
A			
R.			
P€.			
G.			
T.D.	3315		

Loc. in Sec. NE NE NW

Geol.

Contr. Co. tools

Pool Gingrass Ext.

JUN 5 '57

ABANDONED

Date Comm.

M I R MAY 29 57 5-22-57 P 5/8 202

1190 D 2550 JUN 5 57

D&A

Co. Lse. No. Sec. T. R.