


Section 28 Township 23 Range 15-E

Well No. #1 Stout

Company McCausland
Wildcat

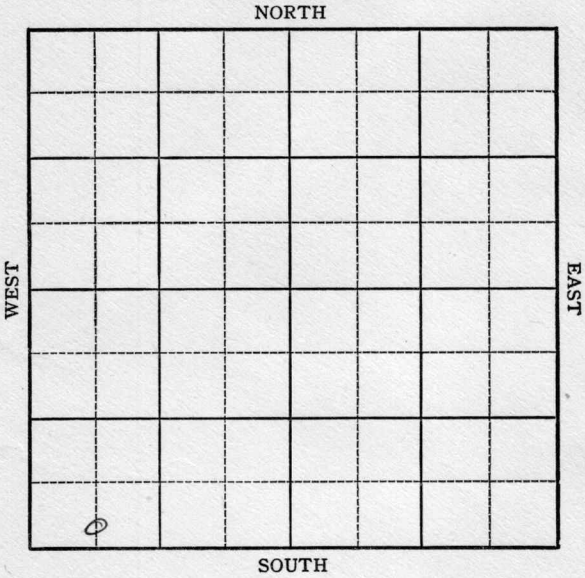

Woodson **KANSAS** 15E ✓
23

Sec. 28 Twp. 23 R. 15E

Well No. #1 Stout Farm

McCausland Company

McCausland Contractor

Wildcat

Ft. from N. Line

200'


Ft. from S. Line

Ft. from E. Line

660'

Ft. from W. Line

C S L SW SW

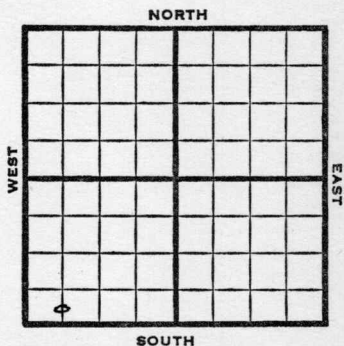

1949

REPORT

11/9 6" @ 800'
Drlg. 1113'

11/16 "

11/23 "

11/29 Drlg 1373'

12/7 "

12/14 Bart 1325'

5" @ 1325'

Drlg. 1418'

12/21 "

12/28 "

1950

4/5 TD 1533'

6"@ 950'

5"@ 1325'

Bart 1325'

D&A


Aband.

ABANDONED

Kansas

Map No. _____ Sec. 28 Twp. 23 R. 15EWell No. 1 Stout_____
McCausland Company_____
McCausland Contractor

C S L SW SW

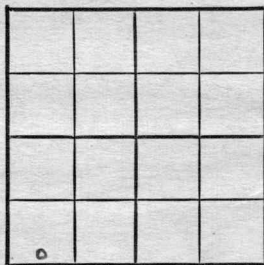FIRST REPORT
SECTION PLAT_____
Ft. from N. Line200
Ft. from S. Line_____
Ft. from E. Line660
Ft. from W. LineWoodson County

Location _____

Rig up _____

Drilling and Remarks:

6" @ 800

drlg. 1113

RECORD

Cased _____ in., _____ ft.

Sand _____

Gas _____

Oil _____

Total Depth _____

PRODUCTION

1st 24 hrs. Nat. _____

1st 24 hrs. after shot _____

Gas _____ Cu. Ft.

Dry Hole _____

Abandoned _____

Date

NOV 9 1949

19

S. J. LEWIS

Scout

