
Harvey KANSAS

SECTION 17 TOWNSHIP 24S RANGE 2E

WELL NO. #5 Gingrass

COMPANY E.H. Adair

SE NW NE

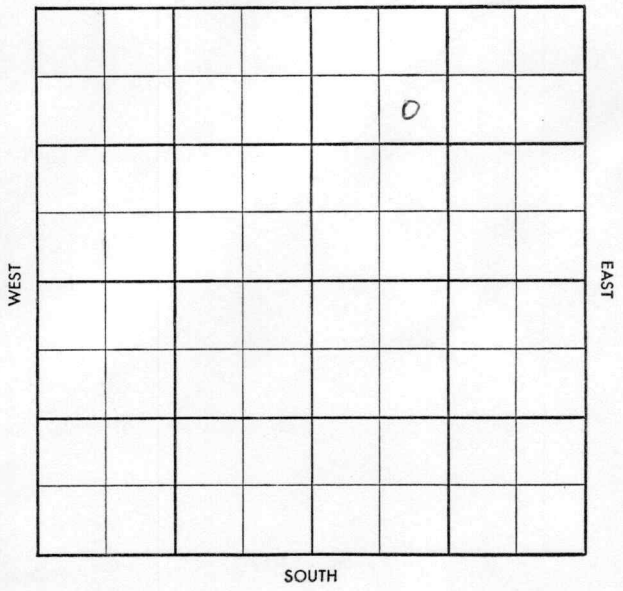

FORM 504-3 SUNRAY

Twp. X Pool X

Co. Fecal 17

S–513–B

County Harvey Elev.

Sec. 17 Twp. 24 Rge. 2E

Company E. H. Adair

Farm Name Gingrass No. 5

TOPS	DEPTH	LOG	DATUM
Anh.			
Tp.			
H.			
Tr.			
Dg.			
B. L.			
L.			
K.C.			
B.K.C.			
Ce.			
C.			
M.			
M.			
K.			
Mz.			
Mq.			
V.			
S.			
S.			
A.			
R.			
Pf.			
G.			
T.D.			

Loc. in Sec. SE NW NE

Geol.

Contr. Co. tools

Pool Gingrass

AUG 6 '58

6

FIRST REPORT

Date Comm.

M I R

Co. Lse. No. Sec. T. R.

Twp._____ Pool_____

Co. K Feet_____

S-513-B

County Harvey Elev. 1420 KB 1418 DF

Sec. 17 Twp. 24 Rge. 2E

Company E. H. Adair

Farm Name Gingrass No. 5

TOPS	DEPTH	LOG	DATUM
Anh.			
Tp.			
H.			
Tr.			
Dg.			
B. L.			
L.			
K.C.			
B.K.C.			
Ce. Burg	2863		
C.			
M.	2911		
M.			
K.	3156		
Mz.	3251		
Mq. Hunt	3252		
V.			
S.			
S.	-		
A.			
R.			
Pf.			
G.			
T.D.	3258		

Loc. in Sec. SE NW NE

Geol.

Contr. Co. tools

Pool Gingrass

AUG 20 '58 D

ABANDONED

Date Comm. 8-7-58 8" 158/100

W I R AUG 13 '58 #2948 AUG 20 '58

D & A

Co. Lse. No. Sec. T. R.