


Section 29 Township 23 Range 15 E

Well No. # 1 Guy

Company Berentz et al

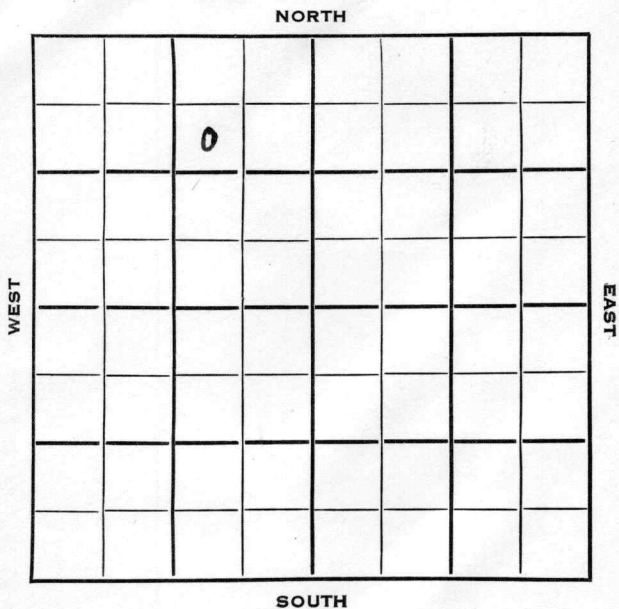

Woodson

KANSAS ✓


Sec. 29 Twp. 23 R. 15EWell No. #1 Guy FarmBerentz et al CompanyBerentz Contractor990 Ft. from N. Line

Ft. from S. Line

990 Ft. from E. Line

Ft. from W. Line

SW NE NW

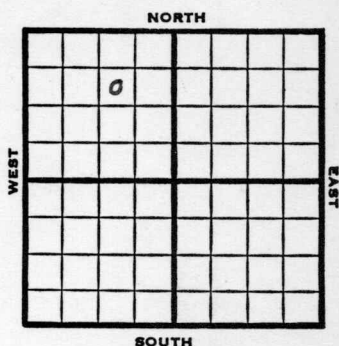

1953

Elev. -

REPORT

5/27

Spud 4-28-53

10" @ 393'

8" @ 760'

Bart 1355', Sq. sd 1117', Miss 1498'

TD 1536'

wtr. PB 1375, wtr. PB 1118'

4" @ 1118'

6/10

Spud 4-28-53 Oil well TD 1536

10" @ 393 8" @ 760 Bart. 1355

Sq. sd. 1117 Miss 1498 TD 1536

wtr. PB 1375 wtr. PB 1118

4" @ 1118 CO to 1132 sd-frac.

Comp. 12 BOPD 36 BW

COMPLETED

County Woodson State Kansas
 Sec. 29 (Blk. 23 (Sur. 15E Map No.
 (Twp.) (Rge.)
 Operator Berentz etal.
 Well No. 1 Farm Guy
 Elev. Location SW NE NW

	0				

MISS. REPORT

990 Ft. From N Line NW
990 Ft. From E Line Quarter

1st. Report MAY 27 1953

Completion

Remarks

Berentz - Contr.

Spudding Date 4-28-53


Drlg. Data

10" @ 393 8" @ 760 Bart. 1355

Sq. sd. 1117 Miss. 1498 TD 1536

wtr. PB 1375 wtr. PB 1118 4" @ 1118

County Woodson State Kansas
 Sec. 29 (Blk.) 23 (Sur.) 15E Map No.
 (Twp.) (Rge.)
 Operator Berentz etal.
 Well No. 1 Farm Guy
 Elev. Location SW NE NW

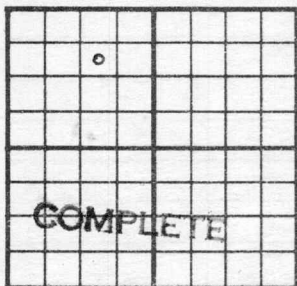

990 Ft. From N Line NW
 990 Ft. From E Line Quarter

1st. Report

Completion JUN 10 1953

Remarks

Berentz - Contr.

Spudding Date 4-28-53

Drlg. Data Oil well TD 1536

10" @ 393 8" @ 760 Bart. 1355

Sq. sd.1117 Miss. 1498 TD 1536

wtr. PB 1375 wtr. PB 1118 4" @ 1118

CO to 1132 sd-frac Comp. 12 bopd 36 bw

J. G. McGEHEE