


Map No. K Sec. 34 Twp. 24 R. 9
Well No. 4 Marshall Farm
Rotana Pet Company

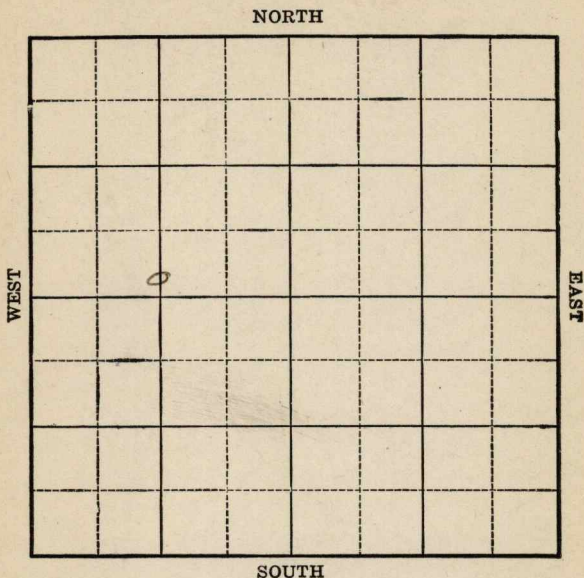

Location _____

Drilling Remarks:

RECORD

Cased _____ in. _____ ft.

Sand _____

Gas _____

Oil _____

Total Depth _____

Rig Up _____

Drilling Remarks:

PRODUCTION

1st 24 hrs. Nat. _____

1st 24 hrs. after shot _____

Gas _____ cu. ft.

Dry Hole _____


Abandoned _____

Map No. _____ Sec. 34 Twp. 24 R. 9Well No. 4 Marshall Farm _____
Rotana Company _____

_____ Ft. from N. Line

200 Ft. from S. Line

_____ Ft. from E. Line

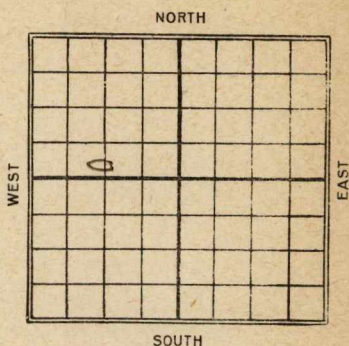1320 Ft. from W. Line

Date

REPORT

192410/8Timbers11/12Sand 2255-2310120 gts 100 Bbls

Map No. KN **KANSAS** Sec. 34 Twp. 24 R. 9

Well No. 4 Marshall

Roxana Company

Contractor

FIRST REPORT

SECTION PLAT

_____ Ft. from N. Line

200 Ft. from S. Line

_____ Ft. from E. Line

1320 Ft. from W. Line

Location _____

Rig up _____

Drilling and Remarks:

Timber

RECORD

Cased _____ in., _____ ft.

Sand _____

Gas _____

Oil _____

Total Depth _____

PRODUCTION

1st 24 hrs. Nat. _____

1st 24 hrs. after shot _____

Gas _____ Cu. Ft.

Dry Hole _____

Abandoned _____

Date

OCT 8 1924

192

M. A. BENEAR

Scout

Map No. 15 **KANSAS** Sec. 34 Twp. 24 R. 9

Well No. 4 Marshall
Rafana Pet Company

Contractor

COMPLETED

SECTION PLAT

_____ Ft. from N. Line

200 Ft. from S. Line

_____ Ft. from E. Line

1320 Ft. from W. Line

Location _____

Rig up _____

Drilling and Remarks:

Sand 2255-2310

120/100

RECORD

Cased _____ in., _____ ft.

Sand _____

Gas _____

Oil _____

Total Depth _____

PRODUCTION

1st 24 hrs. Nat. _____

1st 24 hrs. after shot _____

Gas _____ Cu. Ft.

Dry Hole _____

Abandoned _____

Date

NOV 12 1924

M. A. BENEAR

192

Scout