


Map No. Kane Sec. 29 Twp. 23 R. 15^E
Well No. # 1 Gray (Guy) Farm
Perish et al Company

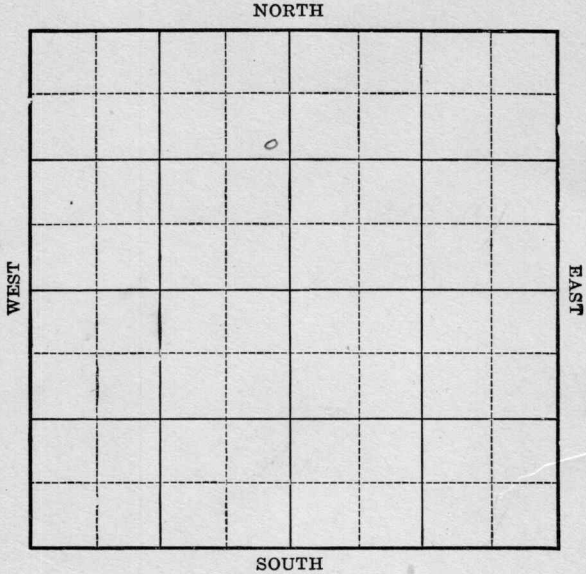

Location _____
Drilling Remarks _____

Rig Up _____
Drilling Remarks _____

RECORD

Cased _____ in. _____ ft.
Sand _____
Gas _____
Oil _____
Total Depth _____

PRODUCTION

1st 24 hrs. Nat. _____
1st. 24 hrs. after shot _____
Gas _____ cu. ft.
Dry Hole _____
Abandoned _____

Map No. K Sec. 29 Twp. 23 R. 15^E

Well No. #1 Gray Farm

Perish et al Company


NORTH

1120 Ft. from N. Line

Ft. from S. Line

200 Ft. from E. Line

Ft. from W. Line

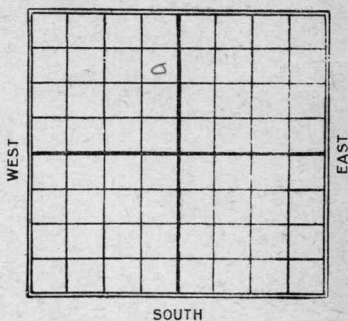

SOUTH

Date _____

REPORT

Date
1924

11/19	Sly 300'
-------	----------

12/17 Hwy 1128'

1925

4/24 1506-1525 40 gt 10 Bbls

Map No. 74770 **KANSAS** Sec. 29 Twp. 23 R. 15-E

Well No. #1 Guy

Pursh et al Company

Contractor

FIRST REPORT

SECTION PLAT

1120 Ft. from N. Line

_____ Ft. from S. Line

200 Ft. from E. Line

_____ Ft. from W. Line

Location _____

Rig up _____

Drilling and Remarks:

300

RECORD

Cased _____ in., _____ ft.

Sand _____

Gas _____

Oil _____

Total Depth _____

PRODUCTION

1st 24 hrs. Nat. _____

1st 24 hrs. after shot _____

Gas _____ Cu. Ft.

Dry Hole _____

Abandoned _____

Date NOV 19 1924

M. A. BENEAR

_____ 192 _____ Scout

Map No. 16400 Sec. 24 Twp. 23 R. 15Well No. 1 Buy
Kalish I al Company

Contractor

COMPLETED

SECTION PLAT

1120 Ft. from N. Line

Ft. from S. Line

200 Ft. from E. Line

Ft. from W. Line

Location

Rig up

Drilling and Remarks:

Tap line 148840/10 b/s

RECORD

Cased _____ in., _____ ft.

Sand 1506-1525

Gas _____

Oil _____

Total Depth _____

PRODUCTION

1st 24 hrs. Nat. _____

1st 24 hrs. after shot _____

Gas _____ Cu. Ft.

Dry Hole _____

Abandoned _____

Date

APR 24 1925

192

Chas L. Shumway
Scout