

Map No. _____, Sec. 34 Twp. 24 R. 7

Well No. 1 Hudson Farm

Company

NORTH

WEST

EAST

SOUTH

Location _____

Drilling Remarks:

Rig up _____

Drilling Remarks:

RECORD

Cased _____ in. _____ ft.

Sand _____

Gas _____

Oil _____

Total Depth_____

PRODUCTION

1st 24 hrs Nat.

1st 24 hrs. after shot_____

Gas _____ cu. ft.

Dry Hole _____

Abandoned _____


Map No. _____ Sec. 34 Twp. 24 R. 9Well No. 1 Nixon Farm _____
Sydney Oil Company _____1120 Ft. from N. Line

_____ Ft. from S. Line

_____ Ft. from E. Line

200 Ft. from W. Line

NORTH

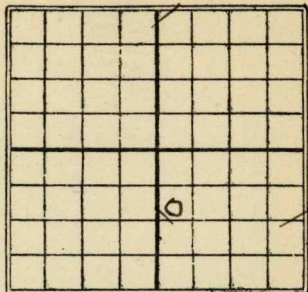

SOUTH

Date

REPORT

19232/24R.O.M.4/20Sand 2150-2184-Shot
60 gts. 75 Bbls.

Map No. **KANSAS** ¹⁵ Sec. **34** Twp. **24** R. **9**

Well No. **1 Nixon**

Gypsey Company

Contractor

FIRST REPORT

1120 Ft. from N. Line

_____ Ft. from S. Line

_____ Ft. from E. Line

200 Ft. from W. Line

SECTION PLAT

		✓	
		○	✓

Location _____

Rig up _____

Drilling and Remarks:

R.O.G.

RECORD

Cased _____ in., _____ ft.

Sand _____

Gas _____

Oil _____

Total Depth _____

PRODUCTION

1st 24 hrs. Nat. _____

1st 24 hrs. after shot _____

Gas _____ Cu. Ft.

Dry Hole _____

Abandoned _____

Date

M. A. BENFAD

FEB 24 1923

Scout

Map No. **KANSAS** ¹⁵ Sec. **34** Twp. **24** R. **9**Well No. **1 Nixon**Company **Gypsy**

Contractor

COMPLETED**SECTION PLAT****1120** Ft. from N. Line

Ft. from S. Line

Ft. from E. Line

200 Ft. from W. Line

Location

Rig up

Drilling and Remarks:

2000 2150-2184
shot 60/75 bbb

RECORD

Cased _____ in., _____ ft.

Sand _____

Gas _____

Oil _____

Total Depth _____

PRODUCTION

1st 24 hrs. Nat. _____

1st 24 hrs. after shot _____

Gas _____ Cu. Ft.

Dry Hole _____

Abandoned _____

Date

APR 20 1923**M. A. BENEAR**

191

Scout