


Map No. K Sec. 31 Twp. 23 R. 15^E
Well No. 1 Weede (Weide) Farm
Franklin Oil Company

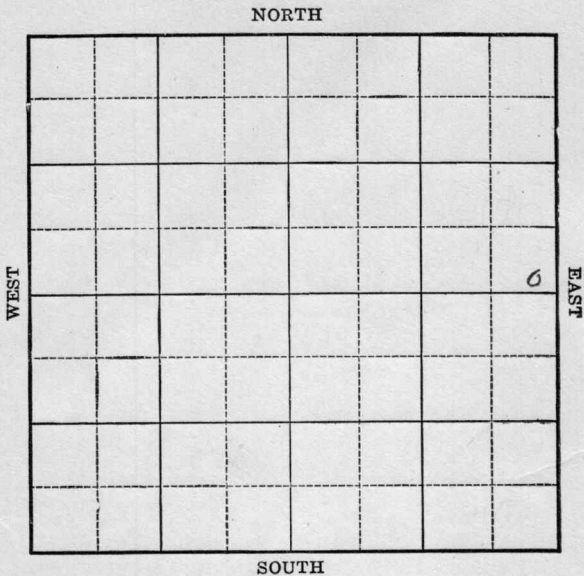

Location _____

Drilling Remarks:

RECORD

Cased _____ in. _____ ft.

Sand _____

Gas _____

Oil _____

Total Depth _____

Rig Up _____

Drilling Remarks:

PRODUCTION

1st 24 hrs. Nat. _____

1st 24 hrs. after shot _____

Gas _____ cu. ft.

Dry Hole _____


Abandoned _____

Map No. K Sec. 31 Twp. 23 R. 15^EWell No. 1 Weede Farm
Franklin Oil Company

Ft. from N. Line

200 Ft. from S. Line200 Ft. from E. Line

Ft. from W. Line

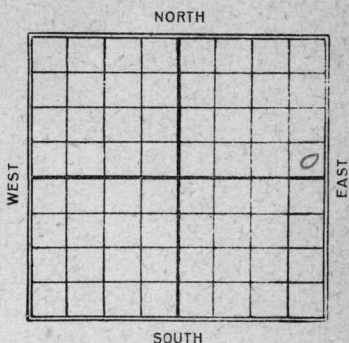

Date

REPORT

192411/1212/174/10

Dlg 200'
sand 1563-69- T.D. 1576
shot 20 gts 600' Oil in hole
300' water
1563-69 T.D. 1576
20 gts 10 Bbls

KANSASMap No. _____ Sec. 31 Twp. 23 R. 15^{1/2}Well No. 1 Weider
Franklin Oil Company

Contractor _____

FIRST REPORT**SECTION PLAT**

_____ Ft. from N. Line

200 Ft. from S. Line200' Ft. from E. Line

_____ Ft. from W. Line

			0

Location _____

Rig up _____

Drilling and Remarks:

D. 200**RECORD**

Cased _____ in., _____ ft.

Sand _____

Gas _____

Oil _____

Total Depth _____

PRODUCTION

1st 24 hrs. Nat. _____

1st 24 hrs. after shot _____

Gas _____ Cu. Ft.

Dry Hole _____

Abandoned _____

Date

NOV 12 1924

192_____

M. A. BENEAR

Scout


Contractor

COMPLETED

SECTION PLAT

Ft. from N. Line

200 Ft. from S. Line200 Ft. from E. Line

Ft. from W. Line

			0

Location

Rig up

Drilling and Remarks:

shot 20 qts10 bls

RECORD

Cased _____ in., _____ ft.

Sand 1563-69

Gas _____

Oil _____

Total Depth 1576

PRODUCTION

1st 24 hrs. Nat. _____

1st 24 hrs. after shot _____

Gas _____ Cu. Ft.

Dry Hole _____

Abandoned _____

Date

APR 10 1925

192

Chas. L. Shewar

Scout