


KANSAS

Woodson

Section 31 Township 23 Range 15-E


Well Number #6 Weide

Company Ward McGinnis

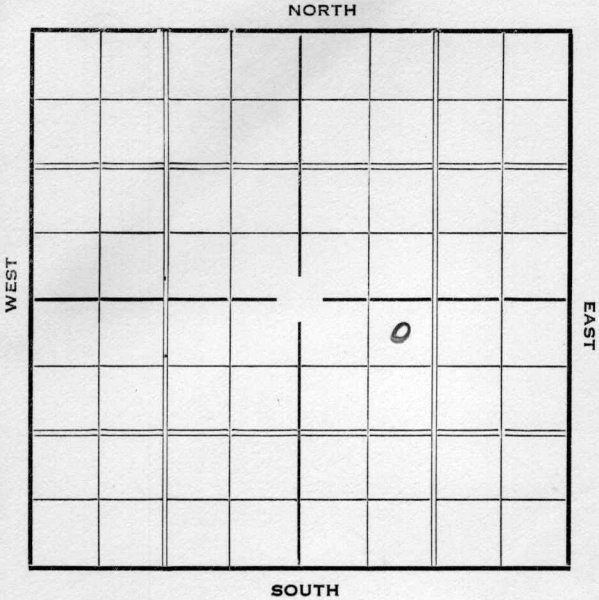

KANSAS

Woodson

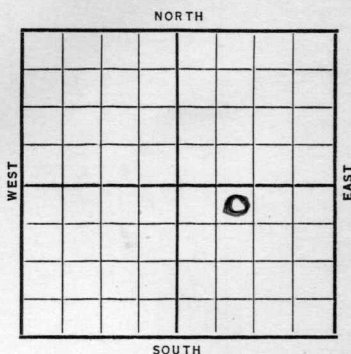Sec. 31 Twp. 23 R. 15-EWell No. #6 Weide FarmWard McGinnis Company330 Ft. from N. Line Ft. from S. Line Ft. from E. Line990 Ft. from W. Line

Date

REPORT

1937

10/13 Mach.

10/22 10" @ 404'. Drlg. 550'.

10/29 8" @ 860'. T.D. 1110'. U.R. 8".

11/5 8" @ 1100'. Miss. 1552'.

T.D. 1580'. 600' oil 24 hrs.

11/10 6" @ 1554'.

Miss. 1552'.

T.D. 1580'.

Potential 15 bbls.

COMPLETED

Woodson

KANSAS

Map No. 17 Sec. 31 Twp. 23 R. 15EWell No. 6 Weide

Ward McGinnis

Company

Contractor

FIRST REPORT

NE NW SE

330 Ft. from N. Line Ft. from S. Line Ft. from E. Line990 Ft. from W. Line

SECTION PLAT

		0	

Location Rig up

Drilling and Remarks:

Mach

RECORD

Cased in., ft.Sand Gas Oil Total Depth

PRODUCTION

1st 24 hrs. Nat. 1st 24 hrs. after shot Gas Cu. Ft.Dry Hole Abandoned

Date

OCT 13 1937 19H. D. Hatfield Scout

Woodson

KANSAS

Map No. 17 Sec. 31 Twp. 23 R. 15EWell No. 6 WeideWard McGinnis

Company

Contractor

COMPLETED

SECTION PLAT

NE NW SE

330 Ft. from N. Line

_____ Ft. from S. Line

_____ Ft. from E. Line

990 Ft. from W. Line

		0	

Location _____

Rig up _____

Drilling and Remarks:

Pot 15

RECORD

Cased 6 in. 1554 ft.Sand MISS 1552

Gas _____

Oil _____

Total Depth 1580

PRODUCTION

1st 24 hrs. Nat. _____

1st 24 hrs. after shot _____

Gas _____ Cu. Ft.

Dry Hole _____

Abandoned _____

Date

NOV 10 1937 19H. D. Hatfield Scout