

Greenwood

Form 51-5M-2-29-34703

Map No. KANSAS

Sec.

Twp.

R.

Well No.

Farm

Company

NORTH

WEST

EAST

SOUTH

cation
rilling Remarks

Rig Up
Drilling Remarks

RECORD

Cased in. ft.
Sand
Gas
Oil
Total Depth

PRODUCTION

1st 24 hrs. Nat.
1st 24 hrs. after shot
Gas cu. ft.
Dry Hole
Abandoned

Greenwood

FORM 252A-5M-12-28-PETROL

Map No. **KANSAS** Sec. 2 Twp. 24 R. 10

Well No. 1-"A" Wale Farm


Beed et al Company

 Ft. from N. Line

330 Ft. from S. Line

330 Ft. from E. Line

 Ft. from W. Line

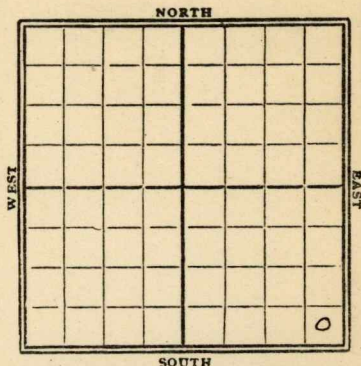

1929

Date

REPORT

4/17	Location
4/24	—
5/1	—
5/18	—
5/15	—
5/22	—
5/29	Run up
6/5	Steady
6/12	Drly 680'
6/19	" 1375'
6/26	" 1900'
7/2	sand 2041-48'
	small show
	Top line 2268'
	Drly 2300'
7/10	
7/17	small show 2041-48'
	Top line 2268'
	TD 2306
	Dry & Abandon

16 **KANSAS** Sec. 2 Twp. 24 R. 10
 Well No. 1 A Dales
 Reed Ct al Company

Contractor

FIRST REPORTS**SECTION PLAT**

Ft. from N. Line

330 Ft. from S. Line

330 Ft. from E. Line

Ft. from W. Line

			0

Location ✓

Rig up

Drilling and Remarks:

RECORD

Cased in., ft.

Sand

Gas

Oil

Total Depth

PRODUCTION

1st 24 hrs. Nat.

1st 24 hrs. after shot

Gas Cu. Ft.

Dry Hole

Abandoned

Date

APR 17 1929

192

CHAS. L. SHERWOOD

Scout

Map No. **KANSAS** Sec. 2 Twp. 24 R. 10
 Well No. 12 Dales
Reed et al Company

Contractor

COMPLETE**SECTION PLAT**

			0

Ft. from N. Line

330 Ft. from S. Line330 Ft. from E. Line

Ft. from W. Line

ABANDONED

Location _____

Rig up _____

Drilling and Remarks:

Small show 2041-48'
Top line 2268'

DDA 2306

RECORD

Cased _____ in., _____ ft.

Sand _____

Gas _____

Oil _____

Total Depth 2306**PRODUCTION**

1st 24 hrs. Nat. _____

1st 24 hrs. after shot _____

Gas _____ Cu. Ft.

Dry Hole ☒Abandoned ☒

Date

JUL 17 1929

19

CHAS. L. SHERWOOD

Scout