


Map No. 71 Sec. 6 Twp. 24 R. 10
Well No. 5 Barthwright Farm
Rogers et al Company

NORTH

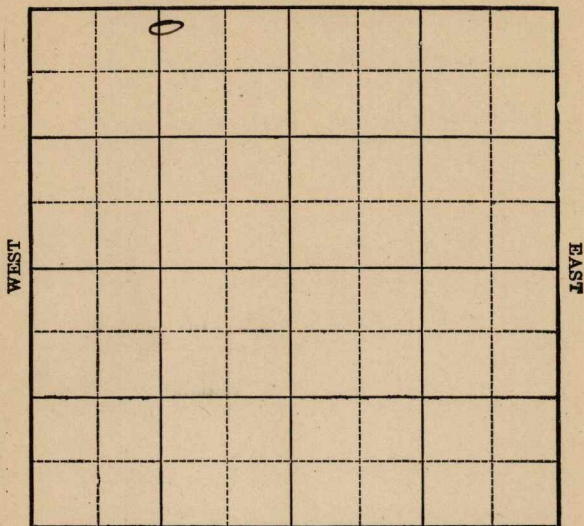

Location _____

Drilling Remarks:

Rig up _____

Drilling Remarks:

RECORD

Cased _____ in. _____ ft.

Sand _____

Gas _____

Oil _____

Total Depth _____

PRODUCTION

1st 24 hrs Nat. _____

1st 24 hrs. after shot_____

Gas _____ cu. ft.

Dry Hole_____

Abandoned _____

Map No.

Sec.

Twp.

R.

Well No.

Farm


Company

200 Ft. from N. Line

Ft. from S. Line

Ft. from E. Line

1320 Ft. from W. Line

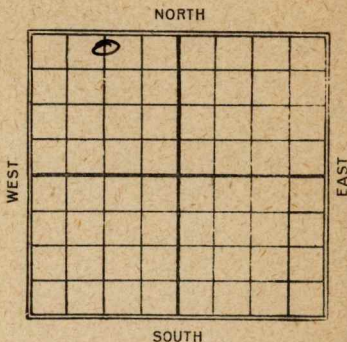

REPORT

1/4/24
 6/10 Location
 7/16 2100'
 10/8 Stand 2177-2257
 180 gals 200 Bbls

Map No. 16 Sec. 6 Twp. 24 R. 10

Well No. # 3 Cartwright

Rogers et al Company

Contractor

SECTION PLAT

FIRST REPORT

200 Ft. from N. Line

Ft. from S. Line

Ft. from E. Line

1320 Ft. from W. Line

Location ✓ ✓

Rig up

Drilling and Remarks:

RECORD

Cased _____ in., _____ ft.

Sand _____

Gas _____

Oil _____

Total Depth _____

PRODUCTION

1st 24 hrs. Nat. _____

1st 24 hrs. after shot _____

Gas _____ Cu. Ft.

Dry Hole _____

Abandoned _____

Date JUN 10 1924 M. A. BENEAR

192 Scout

KH KANSAS
 Map No. _____ Sec. 6 Twp. 24 R. 10

Well No. 5 Cartwright

Pagers et al Company

Contractor

COMPLETED

SECTION PLAT

200 Ft. from N. Line

_____ Ft. from S. Line

_____ Ft. from E. Line

1320 Ft. from W. Line

	①		

Location _____

Rig up _____

Drilling and Remarks:

sand 2177-2257
180/200 lbs

RECORD

Cased _____ in., _____ ft.

Sand _____

Gas _____

Oil _____

Total Depth _____

PRODUCTION

1st 24 hrs. Nat. _____

1st 24 hrs. after shot _____

Gas _____ Cu. Ft.

Dry Hole _____

Abandoned _____

Date

OCT 8 1924

M. A. BENEAR

192

Scout