

Greenwood

KANSAS

SECTION 26 TOWNSHIP 24 RANGE 10 ~~2~~ E

WELL NO. #10 Cartwright

COMPANY Phillips Pot.

NORTH

		0					

WEST

EAST

SOUTH

Greenwood

KANSAS

SEC.

TWP.

R.

± 6

24

9E 10E

WELL NO.

#10 Cartwright

FARM

COMPANY

Phillips Petr.

CONTRACTOR

McGinnis


Ft. from N. Line

Ft. from S. Line

Ft. from E. Line

Ft. from W. Line

SW NE NW

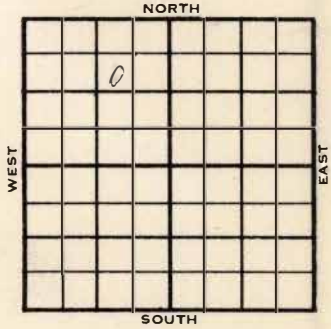

1956

ELEVATION

1322'

REPORT

1-11 Comm. 1-3-56
8" @ 113/75
TD 2358
5" @ 2282
KC. 1802
Marm. 1911
Cherokee 2079
Bart 2230
Bart. sd. 2282

This was originally picked
up 1-24S-9E, corrected to
6-24S-10E

County

Greenwood

Elev.

1322

Sec.

6

Rgs.

9E 10 E

Company

Phillips Petroleum

Farm Name

Cartwright

No. 10

TOPS	DEPTH	LOG	DATUM	Loc. in Sec.
As				SW NE NW
Tp				
H.				
Tr.				
Sp.				
RI				
L.				
K.C.	1872			Geol.
R.C.				
Co. Harn.	1911		589	Conts. McGinnis
C. Cherokee	2079		257	
M. Hart	2230		408	Pool
M. Hart, ad.	2282		960	
V.				
S.				
S.				
A.				
R.				
PC				
G.				
2358				

COMPLETE

Date Comm.

1-3-56

FEB 15 1956

8" @ 113/75 TD 2358 5" @ 2282

JAN 18 '56 CO 2358 Frac Flung Ld.

JAN 25 '56 Flung Ld. FEB 1 '56 ✓ FEB 8 '56 P.

252 BO + 72 BW pd in 7 days

P 155 BO + 47 BW 24 hrs

FEB 15 '56 P. 165 BO + 37 BW pd.

County Greenwood Elev. 1322
Sec. 1 Twp. 24 Rge. 9E
Company Phillips Petroleum
Farm Name Cartwright No. 10

TOPS	DEPTH	LOG	DATUM	Loc. in Sec.
Anh.				SW NE NW
Top				
H.				
Tr.				
Dg.				
Bl.				
L.				Geol.
K.C.	1802			
B.K.C.				Contr.
Ce. Marm.	1911			McGinnis
C.				
M. Cherokee	2079			Pool
M.				
K. Bart	2230			
Mz.				
Mo. Bart. sd.	2282			
V.				
S.				
S.				
A.				
R.				
Pe.				
G.				
T.D.				

Date Comm. 1-3-56
8" @ 113/75 TD 2358 5" @ 2282

0

FIRST REPORT

JAN 11 1956