

Section 6 Township 23 Range 15EWell No. #1 FinelkelCompany W. E. Ellis et al

NORTH

							0

WEST

EAST

SOUTH

Coffey

KANSAS

Sec. 6 Twp. 23 R. 15E ✓

Well No. #1 Finelkel Farm

W. E. Ellis et al Company

Ellis - Contr. Contractor


1000' Ft. from N. Line

_____ Ft. from S. Line

500' Ft. from E. Line

_____ Ft. from W. Line

SE NE NE

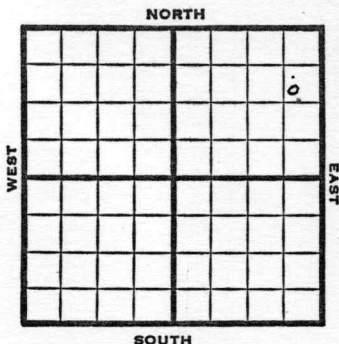

1951

Elev. -

REPORT

4/4

RUR

5/2

Oil Well TD 1560

Miss 1500

TD 1530 5" @ 1512 DD 1560

Comp. 5 bopd

COMPLETED

County Coffey State KansasSec. 6 (Blk. Twp.) 23 (Sur. Rge.) 15E Map No.Operator W. E. Ellis et al.Well No. 1 Farm FinelkelElev. Location SE NE NE

FIRST REPORT

1000 Ft. From N Line NE500 Ft. From E Line Quarter1st. Report APR 4 1951

Completion

Remarks

Ellis - Contr.

Spudding Date

Drig. Data

RUR

J. E. TYRA

J. E. TYRA