


Map No. **KANSAS** Sec. 6 Twp. 24 R. 10 E
Well No. Central Pet Farm _____ Company _____

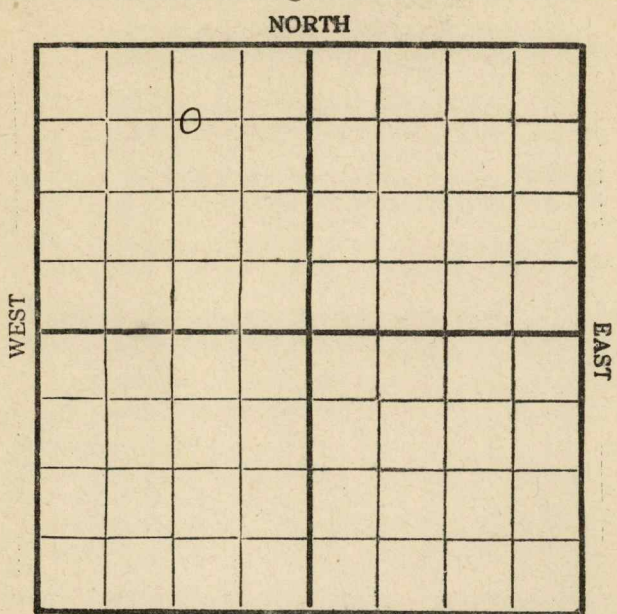

Location _____ Rig Up _____
Drilling Remarks _____ Drilling Remarks _____

RECORD

Cased _____ in. _____ ft.
Sand _____
Gas _____
Oil _____
Total Depth _____

PRODUCTION

1st 24 hrs. Nat. _____
1st 24 hrs. after shot _____
Gas _____ cu. ft.
Dry Hole _____
Abandoned _____

FORM 252A-5M-12-28-PETROL


Map No. **KANSAS** Sec. 6 Twp. 24 R. 10

Well No. 7- Cartwright Farm
Central Ref Co Company

Ft. from S. Line

Ft. from W. Line

1929

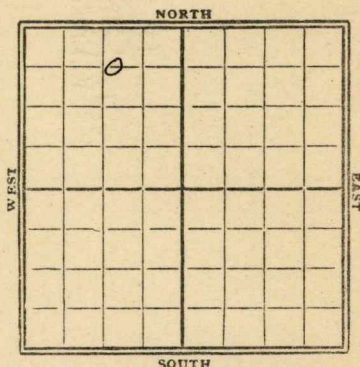

REPORT
Formerly Rogers et al

Date	
8/7	sdy shale 2278-2300 show oil Only 2300'
8/14	sand 2300-60' TD. 2360' shot 80 gts 40 bbls oil Pump.

Map No. *16* **KANSAS** Sec. *6* Twp. *24* R. *10 E*

Well No. *7* *Cartwright*
Central Fuel Co Company

Contractor

FIRST REPORTS

SECTION PLAT

660 Ft. from N. Line

..... Ft. from S. Line

1120 Ft. from E. Line

..... Ft. from W. Line

	<i>0</i>		

Location *Formerly Rogers et al.*

Rig up

Drilling and Remarks:

Ady shale 2278-2300

Show oil

Dry

RECORD

Cased.....in.,ft.

Sand.....

Gas.....

Oil.....

Total Depth.....

PRODUCTION

1st 24 hrs. Nat.....

1st 24 hrs. after shot.....

Gas.....Cu. Ft.

Dry Hole.....

Abandoned.....

Date

AUG 7 1929

CHAS. L. SHERWOOD

192.....

Scout

Sawwood.

Map No. **KANSAS** Sec. 6 Twp. 74 R. 10
 Well No. 7 Cartwright

Center fat Co Company

Contractor

COMPLETE**SECTION PLAT**

	o		

660 Ft. from N. Line

_____ Ft. from S. Line

1170 Ft. from E. Line

_____ Ft. from W. Line

Location _____

Rig up _____

Drilling and Remarks:

80/40 Bb.**RECORD**

Cased _____ in., _____ ft.

Sand 7300-7360

Gas _____

Oil _____

Total Depth 7360**PRODUCTION**

1st 24 hrs. Nat. _____

1st 24 hrs. after shot _____

Gas _____ Cu. Ft.

Dry Hole _____

Abandoned _____

Date

AUG 1 4 1929

19

CHAS. L. SHERWOOD

Scout