

Map No. K Sec. 23 Twp. 24 R. 9


Well No. 2 Halverson Farm
Leonard Pet Company

Ft. from N. Line

1120 Ft. from S. Line

Ft. from E. Line

200 Ft. from W. Line

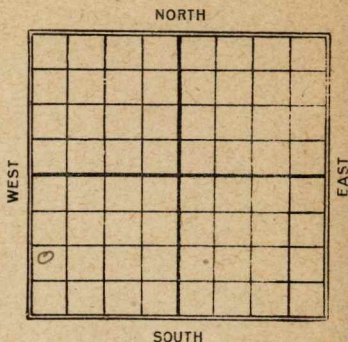

Date _____

REPORT

Date
1924

8/6	Reg up
-----	--------

10/8 Sand 2157-2214

120 qts 60 Bbls

Lot Water

Map No. KANSAS Sec. 23 Twp. 24 R. 9Well No. 2 Halverson
Leonard Pet Company

Contractor _____

SECTION PLAT

FIRST REPORT

_____ Ft. from N. Line

1120 Ft. from S. Line

_____ Ft. from E. Line

200 Ft. from W. Line

Location _____

Rig up ✓ ✓ _____

Drilling and Remarks:

RECORD

Cased _____ in., _____ ft.

Sand _____

Gas _____

Oil _____

Total Depth _____

PRODUCTION

1st 24 hrs. Nat. _____

1st 24 hrs. after shot _____

Gas _____ Cu. Ft.

Dry Hole _____

Abandoned _____

Date

AUG 6 1924

M. A. BENEAR

192

Scout

1515 **KANSAS** Sec. 23 Twp. 24 R. 9

Well No. 2 Halverton
Leonard Pet Company

Contractor

COMPLETED

SECTION PLAT

----- Ft. from N. Line

1120 ----- Ft. from S. Line

----- Ft. from E. Line

200 ----- Ft. from W. Line

0			

Location -----

Rig up -----

Drilling and Remarks:

Land 2137-2214

120/60

Lat water,

RECORD

Cased ----- in., ----- ft.

Sand -----

Gas -----

Oil -----

Total Depth -----

PRODUCTION

1st 24 hrs. Nat. -----

1st 24 hrs. after shot -----

Gas ----- Cu. Ft.

Dry Hole -----

Abandoned -----

Date

OCT 8 1924

192

M. A. BENEAR

Scout