


Map No. Kansas Sec. 23 Twp. 24 R. 9
Well No. 4 Holverson Farm
Leonard Reh Company

NORTH

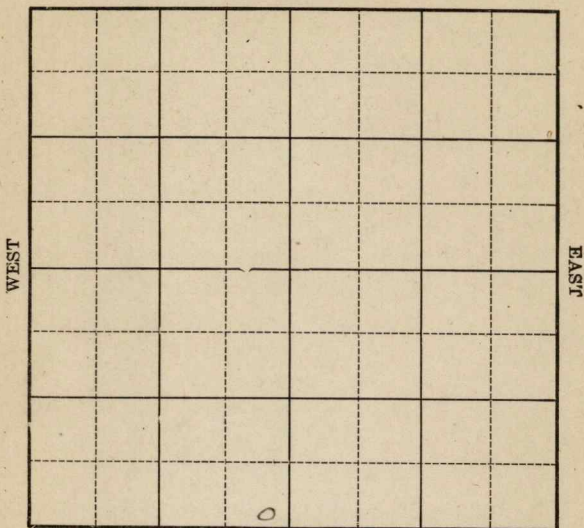

SOUTH

Location _____

Drilling Remarks _____

Rig Up _____

Drilling Remarks _____

RECORD

Cased _____ in. _____ ft.

Sand _____

Gas _____

Oil _____

Total Depth _____

PRODUCTION

1st 24 hrs. Nat. _____


1st 24 hrs. after shot _____

Gas _____ cu. ft.

Dry Hole _____

Abandoned _____

-----Ft. from W. Line

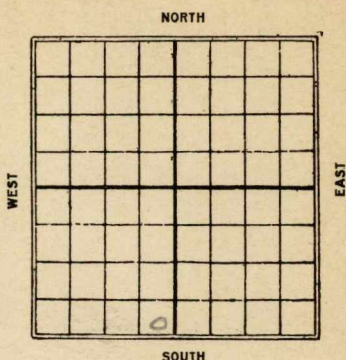

Date	REPORT
1925	
11/27	Bldg Leg
12/3	Repping up.
12/10	Daily 450'
12/17	_____
12/23	_____
12/31	_____
1926	
1/8	Abandoned 2200 ft

1215 KANSAS, 23 Twp. 24 R. 9

Well No. 4 Holoverdon
Leonard Act Co Company

Contractor

SECTION PLAT

_____ Ft. from N. Line

200 _____ Ft. from S. Line

200 _____ Ft. from E. Line

_____ Ft. from W. Line

FIRST REPORTS

Location _____

Rig up _____

Drilling and Remarks:

Blag Rig

RECORD

Cased _____ in., _____ ft.

Sand _____

Gas _____

Oil _____

Total Depth _____

PRODUCTION

1st 24 hrs. Nat. _____

1st 24 hrs. after shot _____

Gas _____ Cu. Ft.

Dry Hole _____

Abandoned _____

Date

NOV 27 1925

CHAS. L. SHERWOOD

192

Scout

15 *Blonwood Co*
 Map No. **KANSAS** Sec. *23* Twp. *24* R. *9*

Well No. *4* **HOLVERSON**
Leonard Jet Co Company

Contractor

COMPLETED

SECTION PLAT

_____ Ft. from N. Line

200 _____ Ft. from S. Line

200 _____ Ft. from E. Line

_____ Ft. from W. Line

ABANDONED

Location _____

Rig up _____

Drilling and Remarks:

Show oil 2076-81'
Shub 2081-2120
Broken Ad 2120-40'
Stop & show
2. D. 2200'

RECORD

Cased _____ in., _____ ft.

Sand _____

Gas _____

Oil _____

Total Depth *2200'*

PRODUCTION

1st 24 hrs. Nat. _____

1st 24 hrs. after shot _____

Gas _____ Cu. Ft.

Dry Hole ☒

Abandoned ☒

Date

JAN 8 1926

192

CHAS. L. SHERWOOD

Scout