


Section 23 Township 24 Range 9E

Well No. #3 Osmudson

Company Cox & Oilyboird Bird

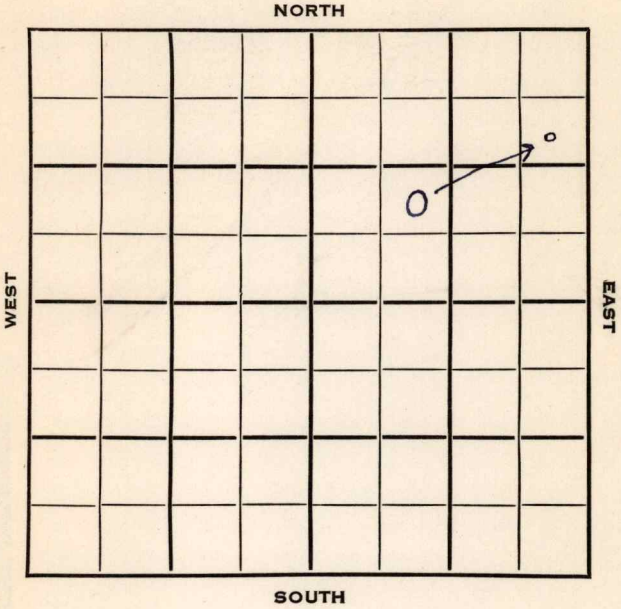

Greenwood

KANSAS

SEC.	TWP.	R.
23	24	9E

WELL NO.

#3 Osmudson FARM

COMPANY

CONTRACTOR

~~BIRD~~
Cox & Oilyboid

Jackman & Jackman

Thrall-Agard Pool


NORTH

990 Ft. from N. Line

990 Ft. from S. Line

330 Ft. from E. Line

990 Ft. from W. Line

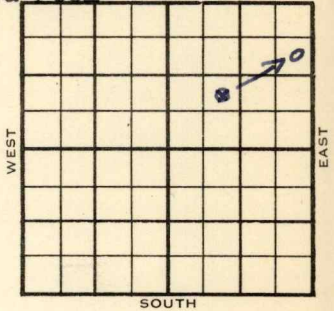

SE NE
NE SW NE

1953	ELEVATION	REPORT
------	-----------	--------

9/30 Cellar & Pits

11/18 Spud 10-30-53
Oil well TD 2281 8" @ 87
Bart. 2270 TD 2281 5" @ 2271
CO to 2281 30 gal. mud acid
FU 28' oil 8 hr. Hydro. S/3 BOPH
Comp. 20 BOPD 5% wtr.

COMPLETED

J. G. McGEHEE

Kansas

Map No. _____ Sec. 23 Twp. 24 R. 9EWell No. 3 Osmudson

Cox & Bird _____ Company

CORRECTION

Contractor

SE NE NE


SECTION PLAT

990 Ft. from N. Line

_____ Ft. from S. Line

330 Ft. from E. Line

_____ Ft. from W. Line

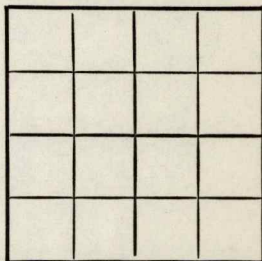

Greenwood County

Location _____

Rig up _____

Drilling and Remarks:

Reported

Cox & Oilyboid

NE SW NE

RECORD

Cased _____ in., _____ ft.

Sand _____

Gas _____

Oil _____

Total Depth _____

PRODUCTION

1st 24 hrs. Nat. _____

1st 24 hrs. after shot _____

Gas _____ Cu. Ft.

Dry Hole _____

Abandoned _____

Date

OCT 28 1953 19

J. G. McGEHEE

Scout

