


Section 23 Township 24 Range 9 E

Well No. # 2 Osmundson

Company Robinson & Cox

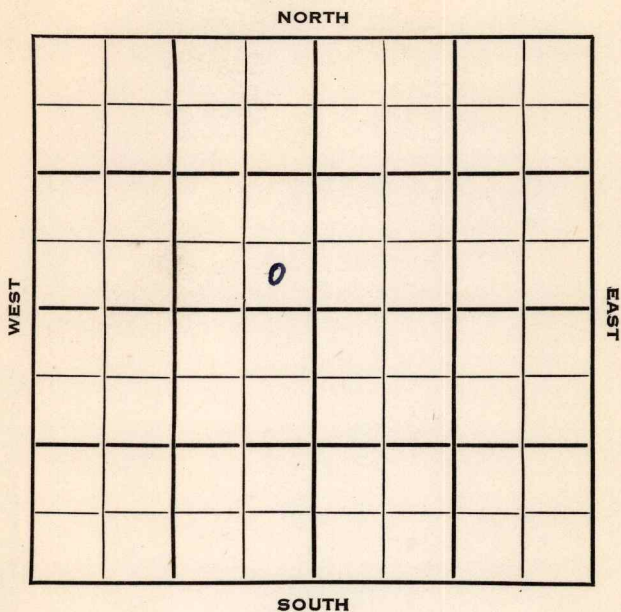

KANSAS


SEC.	23	TWP.	24	R.	9E
WELL NO.					
#2 Osmundson					
COMPANY					
Robinson & Cox					
CONTRACTOR					
Jackman & Jackman					

_____ Ft. from N. Line

330 _____ Ft. from S. Line

330 _____ Ft. from E. Line

_____ Ft. from W. Line

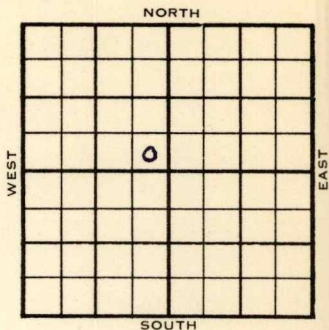

SE SE NW

1953

ELEVATION

Elev. -

REPORT

9/9

Spud 9-4-53

8th @ 57'

Drlg 1550'

9/23

Spud 9-4-53

Oil well TD 2261 8" @ 57 Bart 2246

TD 2261 5" @ 2245 CO to 2261

FU 75' oil 8 hr. Sd-oil-frac.

FU 1400' oil 8 hr.

Comp. 20 BO PD

COMPLETED

