


Coffey

KANSAS

SECTION 7 TOWNSHIP 23 RANGE 15E

WELL NO. #2 Barngrover

COMPANY John Hannah

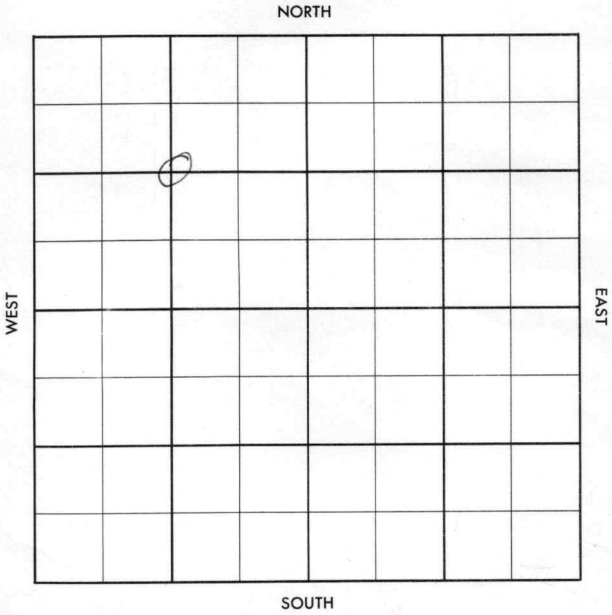

Coffey

KANSAS

SEC.	TWP.	R.
7	23	15E

WELL NO.

#2 Barngrover

FARM

COMPANY

John Hannah

CONTRACTOR

Howard Newland

Van Noy


_____ Ft. from N. Line

_____ Ft. from S. Line

_____ Ft. from E. Line

_____ Ft. from W. Line

C NW/4

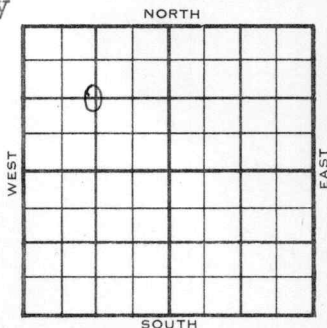

1956

ELEVATION

REPORT

3-28

Comm. 3-24-56
Drlg. 610

4-11

8 5/8" @ 870HFW
D & A
Peru 1183-90
M. 1543'
TD 1586'

ABANDONED

County

~~Coffey~~

Elev.

Sec.

7

Twp.

23

Rge.

15E

Company

~~John Hannah~~

Farm Name

~~Barngrover~~

No.

2

TOPS

DEPTH

LOG

DATUM

Loc. in Sec.

Anh.

T.P.

H.

Tr.

Dg.

B.L.

L.

K.C.

B.K.C.

C.e.

C.

M.

M.

K.

Mz.

Me.

V.

S.

S.

A.

R.

P.e.

G.

T.D.

C NW/4

Geol.

Contr.

Howard Newland

Pool

Van Noy

FIRST REPORT

MAR 28 '56

Date Comm.

3-24-56

drlg. 610

Co.

No.

Sec.

T.

R.

County Coffey Elev. _____
Sec. 7 Twp. 23 Rge. 15E
Company John Hannah
Farm Name Barngrover No. 2

TOPS	DEPTH	LOG	DATUM	Loc. in Sec.
Anh.				C NW/4
TP.				
H.				
Tr.				
Dg.				
Bl.	<u>Peru</u>	<u>1183-90</u>		
L.				Geol. _____
K.C.				Contr. _____
B.K.C.				Howard Newlan
Ce.				Pool _____
C.				Van Noy
M.	<u>1543</u>			
M.				
K.				
Mz.				
Mq.				
V.				
S.				
S.				
A.				
R.				
PE.				
G.				
T.D.	<u>1586</u>			

Date Comm. 3-24-56 APR 11 1956
8 5/8" @ 870 HFW

D & A