


Map No. Kans Sec. 23 Twp. 24 R. 9 ✓

Well No. 7 Wiggins Farm _____
Mission Company _____

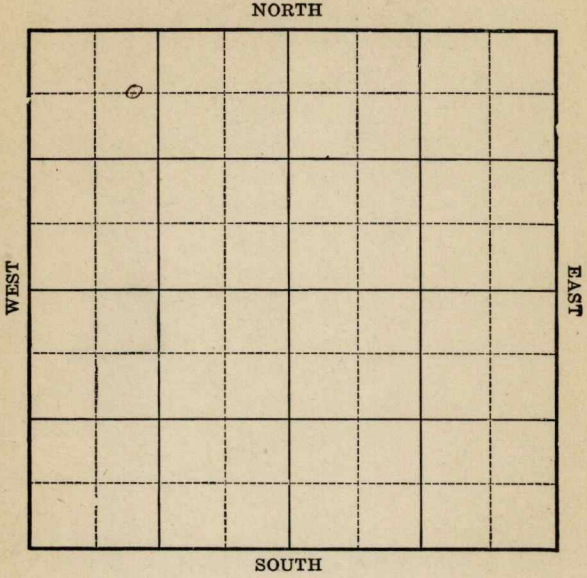

Location _____
Drilling Remarks _____

Rig Up _____
Drilling Remarks _____

RECORD

Cased _____ in. _____ ft.
Sand _____
Gas _____
Oil _____
Total Depth _____

PRODUCTION

1st 24 hrs. Nat. _____
1st. 24 hrs. after shot _____
Gas _____ cu. ft.
Dry Hole _____
Abandoned _____

15
 Map No. **KANSAS** Sec. 23 Twp. 24 R. 9
Well No. 7 WigginsMission Company

Contractor

FIRST REPORT

660 Ft. from N. Line

Ft. from S. Line

Ft. from E. Line

1120 Ft. from W. Line

SECTION PLAT

o			

Location

Rig up ✓ ✓

Drilling and Remarks:

RECORD

Cased _____ in., _____ ft.

Sand _____

Gas _____

Oil _____

Total Depth _____

PRODUCTION

1st 24 hrs. Nat. _____

1st 24 hrs. after shot _____

Gas _____ Cu. Ft.

Dry Hole _____

Abandoned _____

Date

M. A. BENEAR

3/24 1925

Scout

Map No. 151646 Sec. 23 Twp. 24 R. 9Well No. 7 HigginsMission Oil Co Company

Contractor

COMPLETED

SECTION PLAT

660 Ft. from N. Line

Ft. from S. Line

Ft. from E. Line

1120 Ft. from W. Line

0			

Location

Rig up

Drilling and Remarks:

RECORD

Cased in. ft.

Sand 2137-2168

Gas

Oil

Total Depth

PRODUCTION

1st 24 hrs. Nat.

1st 24 hrs. after shot

Gas Cu. Ft.

Dry Hole

Abandoned

Date

MAY 1 1925

192 Scout

CHAS. L. SHERWOOD