

KANSAS

Coffey

Section 15 Township 23 Range 15-EWell No. #2 CrandallCompany James Kilby

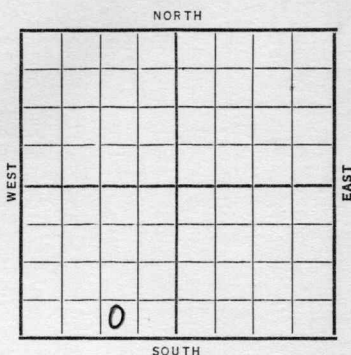
		0					

NORTH

WEST

EAST

SOUTH

Sec. 15 Twp. 23 R. 15-EWell No. #2 Crandall FarmJames Kilby Company Ft. from N. Line330 Ft. from S. Line990 Ft. from E. Line Ft. from W. Line

Date	REPORT
1938	
10/19	R U M
10/28	Dlg. 350'.
11/4	Drlg. 525'.
11/12	10" - 373'. T.D. 759' Esg.
11/18	Dlg. 765'.
11/25	Drlg. 860'.
12/2	T. D. 940'. Rng. 6".
12/9	6" - 940'. Drlg. 960'.
12/15	Miss. 1490'. S. G. 1495-1500'.
	U. R. 5".
12/23	" " " " " "
12/30	" " " " " "
1939	
1/4	5" - 1500'.
	Miss. 1490'.
	T. D. 1510'.
	H.F.W.
	ABANDONED

Coffey

KANSAS

Map No. 17 Sec. 15 Twp. 23 R. 15EWell No. 2 CrandallJames Kilby

Company

Contractor

FIRST REPORT

SW SE SW

 Ft. from N. Line330 Ft. from S. Line990 Ft. from E. Line Ft. from W. Line

SECTION PLAT

	0		

Location Rig up

Drilling and Remarks:

RUM

RECORD

Cased in., ft.Sand Gas Oil Total Depth

PRODUCTION

1st 24 hrs. Nat. 1st 24 hrs. after shot Gas Cu. Ft.Dry Hole Abandoned

Date

OCT 19 1938

19

H. D. Hatfield

Scout

Coffey

KANSAS

Map No. 17 Sec. 15 Twp. 23 R. 15EWell No. 2 CrandallJames Kilby

Company

Contractor

ABANDONED

SW SE SW

 Ft. from N. Line330 Ft. from S. Line990 Ft. from E. Line Ft. from W. Line

SECTION PLAT

	0		

Misc.
~~GRANDALL, POOL~~Location Rig up

Drilling and Remarks:

H.F.W.D & A

RECORD

Cased 5 in., 1500 ft.Sand MISS 1490Gas Oil Total Depth 1570

PRODUCTION

1st 24 hrs. Nat. 1st 24 hrs. after shot Gas Cu. Ft.Dry Hole Abandoned

Date

JAN 4 - 1939

19

H. D. Hatfield

Scout