
FORM 51

Greenwood KANSAS

Section 24 Township 24 Range 9E

Well No. 1 Moore

Company D. A. McDonald

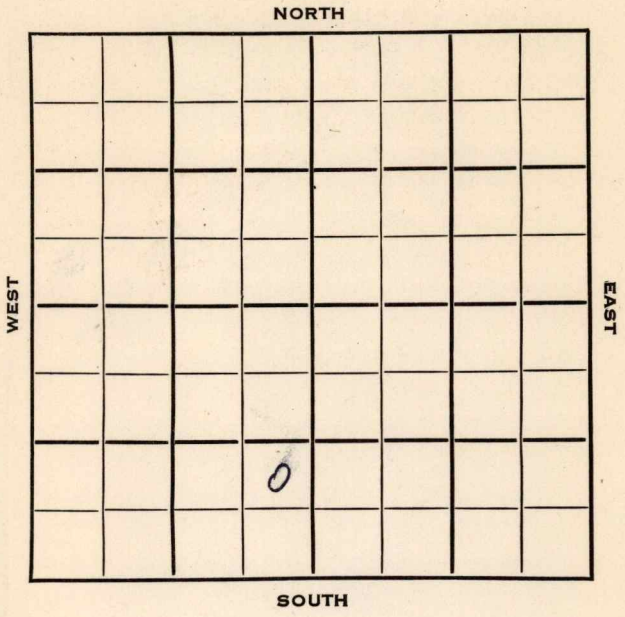

Greenwood KANSAS

SEC.	TWP.	R.
24	24	9 E

WELL NO.

1 Moore FARM

COMPANY

D. A. McDonald

CONTRACTOR

Jackman & Jackman

Thrall-Agard Pool


_____ Ft. from N. Line

990 Ft. from S. Line

330 Ft. from E. Line

_____ Ft. from W. Line

NE SE SW

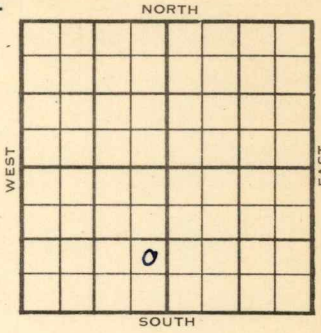

1953	ELEVATION -- REPORT
12/16	Spud 12-13-53 8" @ 40 Drlg. 615'
1954 1/6	Spud 12-13-53 D&A TD 2292' 8" @ 40' Bart 2146' TD 2292' 4" @ 2200' CO to 2156' 18/2146-50,VSSO Hydro. S/40 bwph &SSO D&A

ABANDONED

DX-78

FORM 275 FOR SALE BY KANSAS BLUE PRINT CO.

County Greenwood State Kansas

Sec. 24 (Blk. Twp.) 24 (Sur. Rge.) 9E Map No.

Operator D. A. McDonald

Well No. 1 Farm Moore

Elev. Location NE SE SW



990 Ft. From S Line SW

330 Ft. From E Line Quarter

1st. Report DEC 16 1953

Completion

Remarks

Jackman & Jackman - Cont

Spudding Date 12-13-53

Drlg. Data Thrall-Agard Pool

8" @ 40 drlg. 615

J. G. McGEHEE

FORM 275 FOR SALE BY KANSAS BLUE PRINT CO.

County Greenwood State Kansas

Sec. 24 (Blk. Twp.) 24 (Sur. Rge.) 9E Map No.

Operator D. A. McDonald

Well No. 1 Farm T. Moore

Elev. Location NE SE SW



990 Ft. From S Line SW

330 Ft. From E Line Quarter

1st. Report

Completion JAN 6 1954

Remarks Thrall-Agard Pool

Jackman & Jackman - Contr.

Spudding Date 12-13-53

Drlg. Data D & A TD 2292

8" @ 40 Bart. 2146 TD 2292 4" @ 2200

CO to 2156 18/ 2146-50 VSSO hydro.

S/ 40 bwph & SSO

D & A

J. G. McGEHEE