


Map No. KANSAS Sec. 18 Twp. 23 R. 15^EWell No. T-1 Tebbins Farm
Ritchie & Moore Company

NORTH

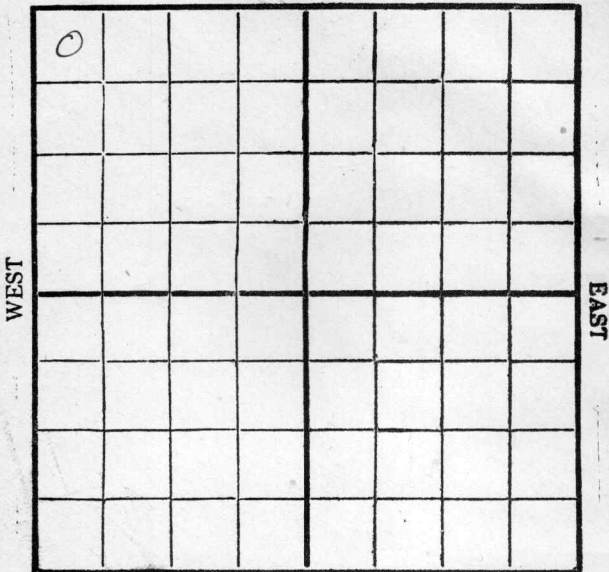

SOUTH

Location _____

Drilling Remarks _____

Rig Up _____

Drilling Remarks _____

RECORD

Cased _____ in. _____ ft.

Sand _____

Gas _____

Oil _____

Total Depth _____

PRODUCTION

1st 24 hrs. Nat. _____

1st 24 hrs. after shot _____

Gas _____ cu. ft. _____

Dry Hole _____

Abandoned _____

Map No. 18 Sec. 23 R. 15^E

Well No. 1 - Lebbins Farm

Ritchie & Moore Company

NORTH


250 Ft. from N. Line

_____ Ft. from S. Line

_____ Ft. from E. Line

250 Ft. from W. Line

1930

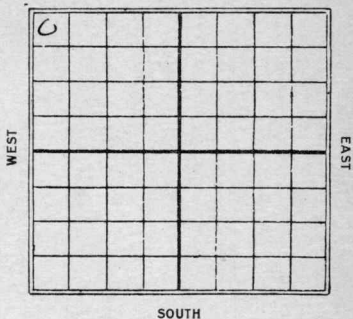

Date

REPORT

1/8

Drily 300'

1/15

" 100'

1/22

No report

1/29

Top Line 1570'
First break 1602-15'
shot 60 qt
Est 30 bbl oil

2/5

Top Line 1570'
Sand 1602-15'
T.D. 1615'

shot 60 qt
45 bbl oil
Pump

KANSAS

Map No. _____ Sec. *18* Twp. *23* R. *15*^EWell No. *1* *Jebbins**Ritchie & Moore* Company

Contractor

FIRST REPORTS

SECTION PLAT

250 Ft. from N. Line

_____ Ft. from S. Line

_____ Ft. from E. Line

250 Ft. from W. Line

<i>0</i>			

Location _____

Rig up _____

Drilling and Remarks:

By 300'

RECORD

Cased _____ in., _____ ft.

Sand _____

Gas _____

Oil _____

Total Depth _____

PRODUCTION

1st 24 hrs. Nat. _____

1st 24 hrs. after shot _____

Gas _____ Cu. Ft.

Dry Hole _____

Abandoned _____

Date

JAN 8 1930

192

CHAS. L. SHERWOOD

Scout

Map No. 17 **KANSAS** Sec. 18 Twp. 73 R. 15

Well No. 1 Jebbins
Ritchie & Moore Company

Contractor

COMPLETE

750 Ft. from N. Line

..... Ft. from S. Line

..... Ft. from E. Line

750 Ft. from W. Line

SECTION PLAT

0			

Location

Rig up

Drilling and Remarks:

Tap here 1570

60/45 Bls.

RECORD

Cased in., ft.

Sand 1602-1615

Gas

Oil

Total Depth 1615

PRODUCTION

1st 24 hrs. Nat.

1st 24 hrs. after shot

Gas Cu. Ft.

Dry Hole

Abandoned

Date

FEB 5 1930

CHAS. L. SHERWOOD

192

Scout