

Section 20 Township 23 Range 15 EWell No. # 1 BrownCompany Directo Oil Co.

NORTH

0							

WEST

EAST

SOUTH

Woodson

KANSAS



Sec. 20 Twp. 23 R. 15E

Well No. #1 Brown Farm

Directo Oil Co.

Company

Eagle - Contr.

Contractor

990'

Ft. from N. Line


Ft. from S. Line

Ft. from E. Line

330'

Ft. from W. Line

SW NW NW

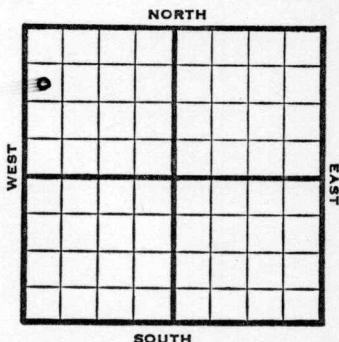

1952

Elev. -

REPORT

6/25


Spud 6-3-52
Drlg. 1090'

8/13

Spud 6-3-52
Oil Well TD 1591
Miss 1545 TD 1586
5" @ 1575 PB 1583 2000 A
 $\frac{1}{2}$ bo & wtr DD 1591
Comp. 10 bopd

COMPLETED

County **Woodson** State **Kansas**
Sec. **20** (Blk.) **23** (Sur.) **15E** Map No.
Operator **Directo Oil Co**
Well No. **1** Farm **Brown**
Elev. Location **SW NW NW**

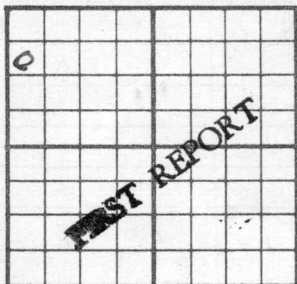

990 Ft. From **N** Line **NW**
330 Ft. From **W** Line Quarter

1st. Report **JUN 25 1952**

Completion

Remarks

Eagle - Contr.

Spudding Date **6-3-52**

Drlg. Data

Drlg. 1090

J. G. McGEHEE

County Woodson State Kansas
 Sec. 20 (Blk. 23 (Sur. 15E Map No.
 (Twp. (Rge.)
 Operator Directo Oil Co.
 Well No. 1 Farm Brown
 Elev. Location SW NW NW

0							

990 Ft. From N Line NW
330 Ft. From W Line Quarter

1st. Report

Completion AUG 13 1952

Remarks

Eagle - Contr.

Spudding Date 6-3-52

Drlg. Data Oil well TD 1591

Miss. 1545 TD 1586 5" @ 1575

PB 1583 2000 A $\frac{1}{2}$ bo & water DD 1591

Comp. 10 bopd

J. G. McGEHEE