
KANSAS Woodson

FORM 51 5M 2-38 TPCO.

Section 21 Township 23 Range 15-E

Well No. #1 Evans

Company John Dunne

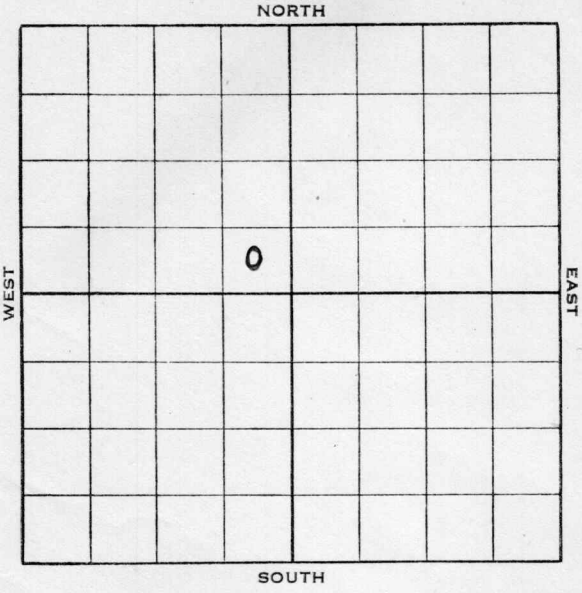


FORM 252-A 5M 10-38 KANSAS Woodson

Sec. 21 Twp. 23 R. 15-E

Well No. #1 Evans Farm

John Dunne Company

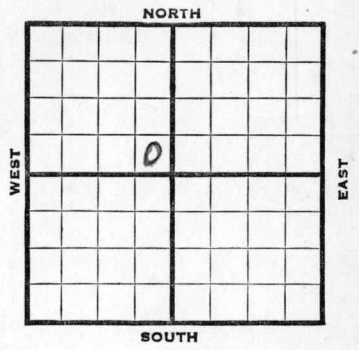

_____ Ft. from N. Line

330 Ft. from S. Line

330 Ft. from E. Line

_____ Ft. from W. Line

1938	REPORT
11/2	Drlg. 645'.
11/12	10" - 21'. 8" - 849'.
	Dlg. 1003'.
11/18	6" - 1241'. Dlg. 1450'.
11/25	Miss. 1520'. Rng. 5".
12/2	T. D. 1541' S. O. 5" - 1520'.
	C. O.
12/9	T. D. 1545'. 1000 acid.
12/15	" " " " "
12/21-	5" - 1520'.
	Miss. 1520'.
	T. D. 1545'.
	1000 acid.
	15 bbls. oil. No water.
	COMPLETED

Form 26—1M Bks.—2-29 Woodson KANSAS

Map No. 17 Sec. 21 Twp. 23 R. 15E

Well No. 1 Evans

John Dunne Company

Contractor

FIRST REPORT

SE NW


Ft. from N. Line

330 Ft. from S. Line

330 Ft. from E. Line

Ft. from W. Line

SECTION PLAT

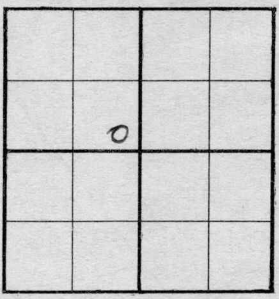

Location

Rig up

Drilling and Remarks:

Drlg. 645

RECORD

Cased in., ft.

Sand

Gas

Oil

Total Depth

PRODUCTION

1st 24 hrs. Nat.

1st 24 hrs. after shot

Gas Cu. Ft.

Dry Hole

Abandoned

Date

NOV 2 - 1938

19

H. D. Hatfield Scout

Form 26—1M Bks.—2-29 Woodson KANSAS

Map No. 17 Sec. 21 Twp. 23 R. 15E

Well No. 1 Evans

John Dunne Company

Contractor

COMPLETED

SE NW

Ft. from N. Line


330 Ft. from S. Line

330 Ft. from E. Line

Ft. from W. Line

EVANS POOL

SECTION PLAT

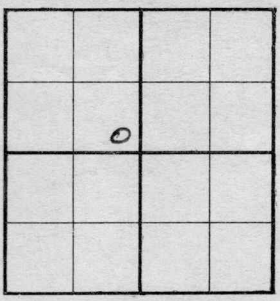

Location

Rig up

Drilling and Remarks:

1000 acid

15 oil

No WTR

RECORD

Cased 5 in., 1520 ft.

~~Sand~~ Miss 1520

Gas

Oil

Total Depth 1545

PRODUCTION

1st 24 hrs. Nat.

1st 24 hrs. after shot

Gas Cu. Ft.

Dry Hole

Abandoned

Date

DEC 21 1938 19 H. D. Hatfield Scout