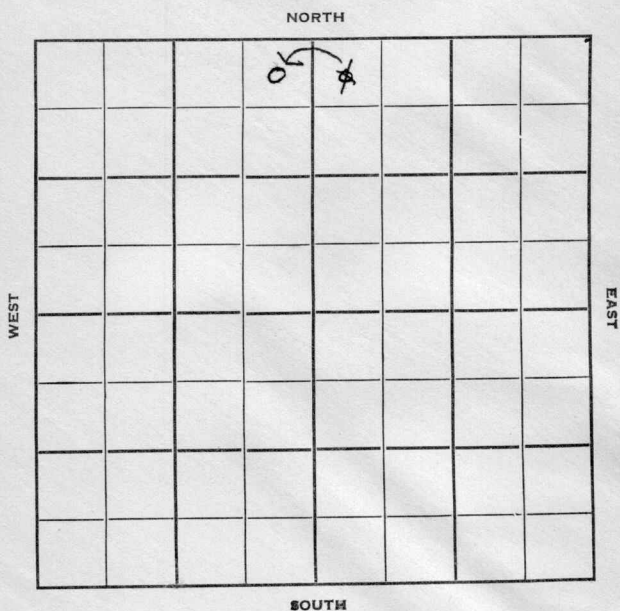


Section 28 Township 23 Range 15-EWell No. #1 StockerbrandCompany Rogers & Evans

Woodson

KANSAS

Sec. 28 Twp. 23 R. 15E

Well No. #1 Stockerbrand Farm

Rogers & Evans

Company

Contractor

Evans Pool

330' Ft. from N. Line


Ft. from S. Line

330 Ft. from E. Line

330' Ft. from W. Line

~~NW NW NE~~

NE NE NW

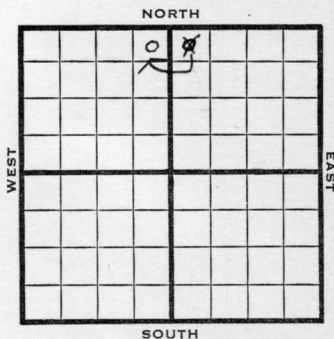

1950

?

REPORT

8/9

Drlg. 240'
Spd 8-5-50

9/6

8" @ 807
Miss 1502
5" @ 1502
TD 1526
FU 270' oil over nite
B/7 bo 8 bw
Comp 18 bopd 25% wtr
Completed

COMPLETED

Kansas


Map No. _____ Sec. 28 Twp. 23 R. 15EWell No. 1 Stockerbrand_____
Rogers & Evans Company_____
CORRECTION Contractor

NE NE NW

SECTION PLAT

330 Ft. from N. Line_____
Ft. from S. Line330 Ft. from E. Line_____
Ft. from W. Line

Woodson County

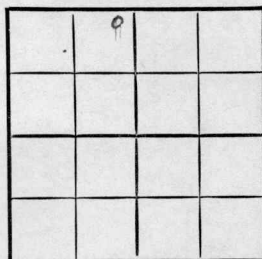

Location _____

Rig up _____

Drilling and Remarks:

Reported

NW NW NE

RECORD

Cased _____ in., _____ ft.

Sand _____

Gas _____

Oil _____

Total Depth _____

PRODUCTION

1st 24 hrs. Nat. _____

1st 24 hrs. after shot _____

Gas _____ Cu. Ft.

Dry Hole _____

Abandoned _____

Date

AUG 23 1950 19

J. E. TYRA

County Woodson State KansasSec. 28 (Blk.
Twp.) 23 (Sur.
Rge.) 15E Map No.Operator Rogers & EvansWell No. 1 Farm StockerbrandElev. Location NE NE NW

			0				

COMPLETE

330 Ft. From N Line NW330 Ft. From E Line Quarter

1st. Report

Completion SEP 6 1950

Remarks

Evans PoolSpudding Date 8-5-50Drlg. Data Oil well TD 15268" @ 807 Miss. 1502 5" @ 1502TD 1526 FU 270' oil over niteB/ 7 bo 8 bw Comp. 18 bopd 25% water

J. E. TYRA