


Map No. Kansas Sec. 26 Twp. 24 R. 9
Well No. 2 Holmerson Farm
Rogers et al Company

NORTH

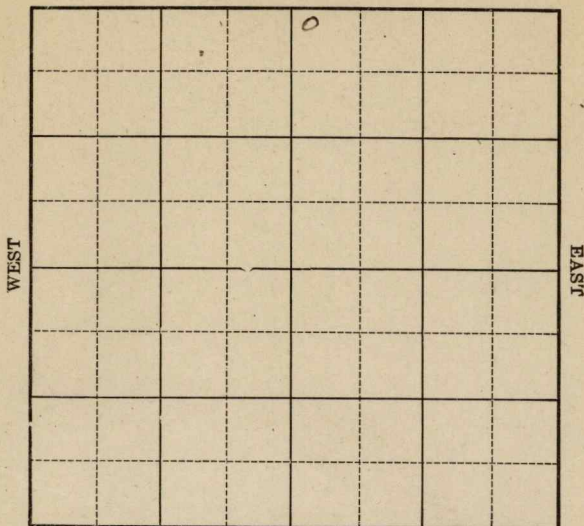

Location _____

Drilling Remarks _____

Rig Up _____

Drilling Remarks _____

RECORD

Cased _____ in. _____ ft.
Sand _____
Gas _____
Oil _____
Total Depth _____

PRODUCTION

1st 24 hrs. Nat. _____
1st 24 hrs. after shot _____
Gas _____ cu. ft.
Dry Hole _____
Abandoned _____


Map No. 14 Sec. 26 Twp. 24 R. 9
Well No. 2 Holverson Farm
Rogers et al Company

200 Ft. from N. Line

Ft. from S. Line

Ft. from E. Line

200 Ft. from W. Line

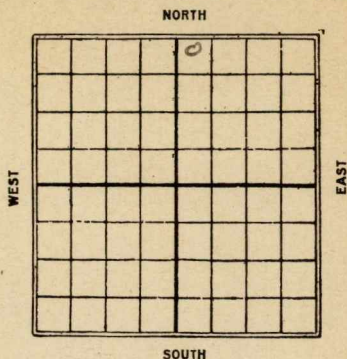

Date	REPORT
1925	
11/27	Location
12/3	—
12/10	—
12/17	—
12/23	—
12/31	—
1926	
1/8	—
1/14	—
1/20	—
1/27	—
2/4	—
2/10	—
2/17	—
2/24	—
3/3	—
3/10	—
3/18	Abandoned Loc

Map No. **KANSAS** Sec. **26** Twp. **24** R. **9**

Well No. **2** **Holoverdon**
Rogers et al Company

Contractor

SECTION PLAT

		0	

200

Ft. from N. Line

Ft. from S. Line

Ft. from E. Line

200

Ft. from W. Line

FIRST REPORTS

Location ☒

Rig up

Drilling and Remarks:

RECORD

Cased _____ in., _____ ft.

Sand _____

Gas _____

Oil _____

Total Depth _____

PRODUCTION

1st 24 hrs. Nat. _____

1st 24 hrs. after shot _____

Gas _____ Cu. Ft.

Dry Hole _____

Abandoned _____

Date

NOV 27 1925

CHAS. L. SHERWOOD

192

Scout

K15 **KANSAS** *26* *24* *9*
 Map No. Sec. Twp. R.

Well No. *2* *Holoveron*
Rogers et al Company

Contractor

COMPLETED

SECTION PLAT

200 Ft. from N. Line

_____ Ft. from S. Line

_____ Ft. from E. Line

300 Ft. from W. Line

ABANDONED

		o	

Location _____

Rig up _____

Drilling and Remarks:

RECORD

Cased _____ in., _____ ft.

Sand _____

Gas _____

Oil _____

Total Depth _____

PRODUCTION

1st 24 hrs. Nat. _____

1st 24 hrs. after shot. _____

Gas _____ Cu. Ft.

Dry Hole _____

Abandoned *Location*

Date

MAR 18 1926

192

CHAS. L. SHERWOOD

Scout