

Sec. 26 Twp. 24 Range 9E

#3 Holverson

Kansas Geological Society

Skelly Scout Tickets

Sec. 26 Twp. 24 Rge. 9E  
 Owner Polhamus Etal  
 Farm Holover Well No. 3  
 County Greene

Feet from lines: N 400 S 200 W  
 NORTH

Casing used.....

15½ ..... ft.

12½ ..... ft.

10 ..... ft.

8¼ ..... ft.


6¾ ..... ft.

5 3-16 ..... ft.

Location .....

Rig .....

WEST

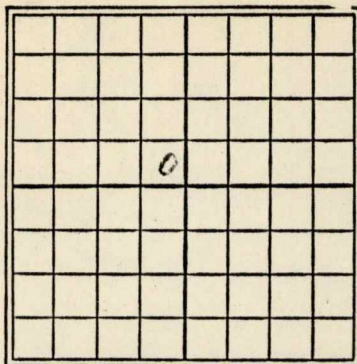

EAST

SOUTH

Drilling at ..... ft. Fishing at ..... ft.

Total Depth 2634 Completed ☒

1st 24 Hrs. Nat. ..... Producing ☒

1st 24 Hrs. Shot ..... Dry Hole ☒

Gas ..... Cu. ft. Abandoned

Sands—give name and depth. Top 2458 Bottom 2464

show oil

MAPPED

Date of Report 1927 of 10

Reported by 1927 J. H. SALADIN