


Section 35 Township 23 Range 14-E

Well No. #7 Massey

Company Aikman & Braden

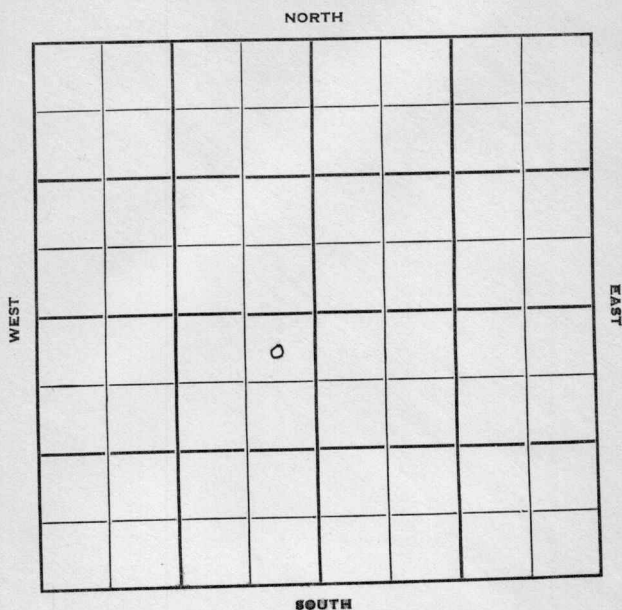

KANSAS

Woodson

Sec. 35 Twp. 23 R. 14-E

Well No. #7 Massey Farm

Aikman & Braden Company

Contractor


330 Ft. from N. Line

Ft. from S. Line

330 Ft. from E. Line

Ft. from W. Line

NE NE SW

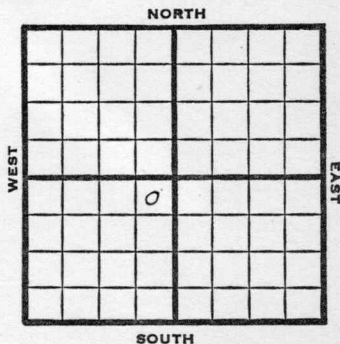

1950

REPORT

7/19 TD 1615
Miss 1603-09
5" @ 1603
2000 acid
Comp 75 BOPD
Completed

FIRST REPORT

COMPLETED

Map No. _____ Sec. 35 Twp. 23 R. 14EWell No. 7 MasseyAikman & Braden

Company

Contractor

NE NE SW


SECTION PLAT

330 Ft. from N. Line

_____ Ft. from S. Line

330 Ft. from E. Line

_____ Ft. from W. Line

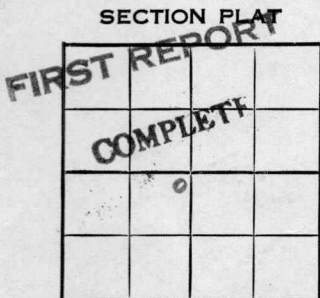Woodson County

Location _____

Rig up _____

Drilling and Remarks:

Miss. 1603-09

5" @ 1603

TD 1615

2000 acid

Comp. 75 bopd

RECORD

Cased _____ in., _____ ft.

Sand _____

Gas _____

Oil _____

Total Depth 1615

PRODUCTION

1st 24 hrs. Nat. _____

1st 24 hrs. after shot _____

Gas _____ Cu. Ft.

Dry Hole _____

Abandoned _____

Date

JUL 19 1950

19

J. E. TYRA

Scout

Map No. _____ Sec. _____ Twp. _____ R. _____

Well No. _____

Alman & Braden

Company

We do not show a #7 well here
Please check and advise

Sam

SECTION _____



_____ Ft. from N. Line

_____ Ft. from S. Line

_____ Ft. from E. Line

_____ Ft. from W. Line

Woodson County

RECORD

Cased

Sand

Gas

Oil

Total Depth _____

Location

Rig up

Drilling and Remarks

_____ 1903-09

_____ 1903

_____ 1915

_____ 2000

_____ 75

AUG 7 1950

Scout Cards 7

Land Small Map

Land Wall Map

Tracings

France Map

Pierce Map

Misc.

Date