


Section 26 Township 24 Range 9E

Well No. #4 Wiggans

Company Stewart Oil

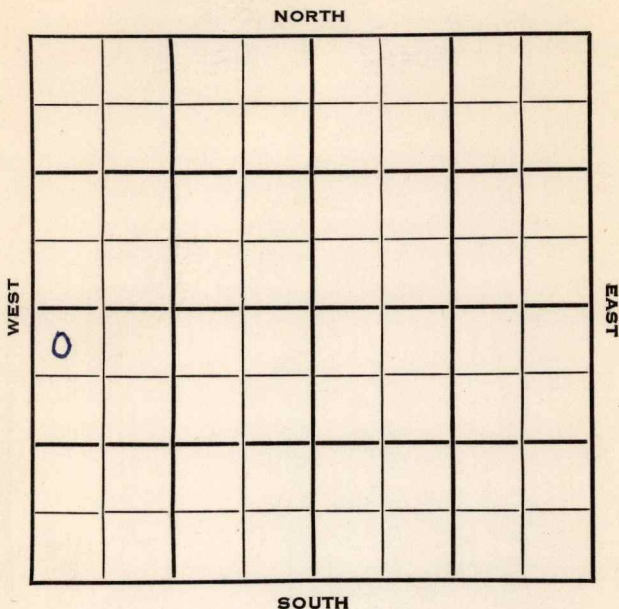

Greenwood KANSAS

SEC. 26	TWP. 24	R. 9E ✓
------------	------------	------------

WELL NO.

4 Wiggans

FARM

COMPANY

Stewart Oil

CONTRACTOR


White & Ellis

330 Ft. from N. Line

Ft. from S. Line

Ft. from E. Line

330 Ft. from W. Line

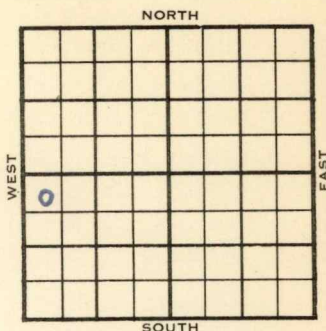

NW NW SW

1954

ELEVATION

REPORT

2/3

Spud 2-1-54
8" @ 100' WQC

2/17

Spud 2-1-54 Oil well TD 2312
8" @ 100 Lans. 1207 KC 1499
B KC 1649 Bart 2112 Miss 2290
TD 2312 5" @ 2164 CO to 2140
24/2114-18 sd-frac
Comp. 25 BOPD

COMPLETED

County Greenwood State Kansas

Sec. 26 (Blk.) 24 (Sur.) 9E Map No.

Operator Stewart Oil

Well No. 4 Farm Wiggins

Elev.	Location	NW	NW	SW
-------	----------	----	----	----

0

FIRST REPORT

330 Ft. From N Line SW

330 Ft. From W Line Quarter

1st. Report FEB 3 1954

Completion

Remarks

White & Ellis - Contr.

Spudding Date 2-1-54

Drlg. Data

8" @ 100 WCC

WCC

J. G. McGEHEE

County Greenwood State Kansas
 Sec. 26 (Blk.) 24 (Sur.) 9E Map No.
 Operator Stewart Oil
 Well No. 4 Farm Wiggans
 Elev. Location NW NW SW



330 Ft. From N Line SW
330 Ft. From W Line Quarter

1st. Report

Completion FEB 17 1954

Remarks

White & Ellis - Contr.

Spudding Date 2-1-54

Drilg. Data Oil well TD 2312
8" @ 100 Lans. 1207 KC 1499
B KC 1649 Bart. 2112 Miss. 2290
TD 2312 5" @ 2164 CO to 2140
24/ 2114-18 sd-frac Comp. 25 bopd

J. G. McGEHEE