


Section 35 Township 23 Range 14-E
 Well No. #5 Mackoolt *(McCoilt)*
 Company Berry & Ells

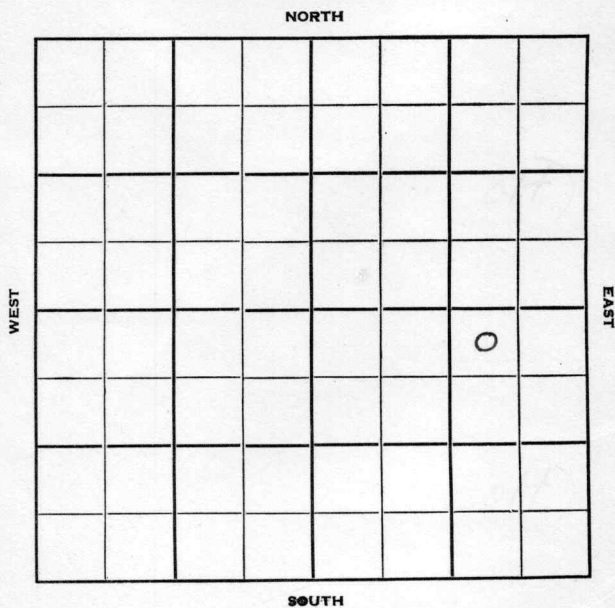

Woodson

KANSAS

Sec. 35 Twp. 23 R. 14E

Well No. #5 Mackcolt Farm

Berry & Ells Company

Brown - Contr. Contractor


330' Ft. from N. Line

 Ft. from S. Line

990' Ft. from E. Line

 Ft. from W. Line

NW NE SE

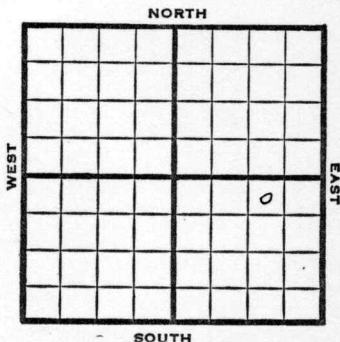

1950

?

REPORT

11/15

RUR

12/6

Miss 1600

TD 1616

4" @ 1616

Pay 1619-27 TD

TD 1627

Comp 5 bopd

Completed

COMPLETED

J. E. TYRA

County

Woodson

State

Kansas

Sec.

35

(Blk.)
(Twp.)

23

(Sur.)
(Rge.)

14E

Map No.

Operator

Berry & Ells

Well No.

5 Farm

Mackcolt

Elev.

Location

NW NE SE

330

Ft. From

N

Line

SE

990

Ft. From

E

Line

Quarter

1st. Report

Completion

DEC 6

1950

Remarks

Brown - Contr.

Spudding Date

Drlg. Data

Oil well

TD 1627

Miss. 1600

TD 1616

4th @ 1616

Pay 1619-27 TD

Comp. 5 bopd

J. E. TYRA