


Woodson

Form 51-5M-4-27-27423

Map No. KANSAS Sec 35 Twp. 23 R. 14

Well No. 1 Simpson Farm
Underwood & Patterson Company

NORTH Kansas Oil

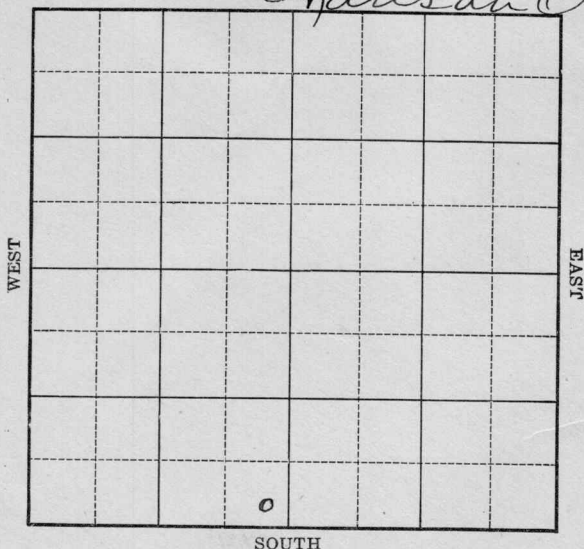

Location _____

Drilling Remarks _____

Rig Up _____

Drilling Remarks _____

RECORD

Cased _____ in. _____ ft.

Sand _____

Gas _____

Oil _____

Total Depth _____

PRODUCTION

1st 24 hrs. Nat. _____

1st 24 hrs. after shot _____

Gas _____ cu. ft.

Dry Hole _____

Abandoned _____

Map No. Sec. 33 Twp. 23R 14

Well No. 1 Simpson Farm

Lynnerwood Patterson Company


Phinsan Oil Co. NORTH

Ft. from N. Line

250 Ft. from S. Line

250 Ft. from E. Line

Ft. from W. Line

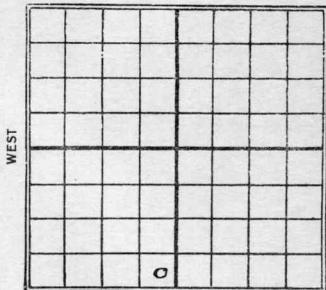

SOUTH

1928

Date _____

REPORT

9/5	<u>Spudding</u>
9/5	

9/12

9/19 S/D. 877'

9/26 Drlg 900'

10/3	S.D. 900'
------	-----------

10/10

10/17	Only 1600'
-------	------------

10/24

10/31	S.D.	1600'
-------	------	-------

11/7 Top line 1625'

Show 1645-54

TD 1660'

Dry & Abandoned

[illegible][illegible]

[illegible]

MAP No. KANSAS SEC. 35 TWP. 23 R. 14

WELL No. 1 Simpson

Underwood & Patterson COMPANY

CONTRACTOR

SECTION PLAT

FIRST REPORTS

250 Ft. FROM N. LINE

250 Ft. FROM S. LINE

250 Ft. FROM E. LINE

 Ft. FROM W. LINE

LOCATION

RIG UP

DRILLING AND REMARKS:

Spudding

RECORD

CASED IN. FT.

SAND

GAS

OIL

TOTAL DEPTH

PRODUCTION

1ST 24 HRS. NAT.

1ST 24 HRS. AFTER SHOT

GAS Cu. Ft.

DRY HOLE

ABANDONED

DATE
SEP 5 1928

CHAS. L. SHERWOOD

192

SCOUT

Woodson

KANSAS
 MAP NO. 10 SEC. 35 TWP. 23 R. 14
 WELL NO. 1 Simpson
Kanson Oil Co. COMPANY

CONTRACTOR

SECTION PLAT

CORRECTION

Ft. FROM N. LINE

250 Ft. FROM S. LINE250 Ft. FROM E. LINE

Ft. FROM W. LINE

RECORD

LOCATION S/O 877'

RIG UP

DRILLING AND REMARKS:

chg ownership

CASED _____ IN. _____ FT.

SAND _____

GAS _____

OIL _____

TOTAL DEPTH _____

PRODUCTION

1ST 24 HRS. NAT. _____

1ST 24 HRS. AFTER SHOT _____

GAS _____ CU. FT.

DRY HOLE _____

ABANDONED _____

DATE
SEP 19 1928

CHAS. L. SHERWOOD

192

SCOUT

KANSAS

MAP NO. _____ SEC. 35 TWP. 23 R. 14WELL NO. 1

Kanson

Simpson Oil Co

COMPANY

CONTRACTOR

COMPLETED

SECTION PLAT

	0		

Ft. FROM N. LINE

250

Ft. FROM S. LINE

250

Ft. FROM E. LINE

Ft. FROM W. LINE

ABANDONED

LOCATION _____

RIG UP _____

DRILLING AND REMARKS:

Top line 1625
 Show 1645-54
 DQ at 1660

RECORD

CASED _____ IN. _____ FT.

SAND _____

GAS _____

OIL _____

TOTAL DEPTH 1660'

PRODUCTION

1ST 24 HRS. NAT. _____

1ST 24 HRS. AFTER SHOT _____

GAS _____ Cu. Ft.

DRY HOLE ☒ABANDONED ☒

DATE

NOV 7

1928

CHAS. L. SHERWOOD

192

SCOUT