


Map No. KANSAS Sec. 35 Twp. 23 R. 14
Well No. 2- Simpson Farm
Kansas Oil Co Company

_____ Ft. from N. Line

1120 Ft. from S. Line

1120 Ft. from E. Line

_____ Ft. from W. Line

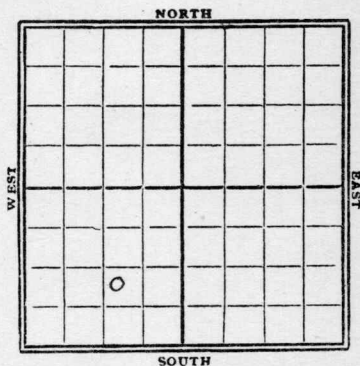

1929

Date

REPORT

7/2	Machine
7/10	
7/17	Spdy
7/24	drill 750'
7/31	Top line 1655'
	Pay 1660-66
	TD 1671' P.B. 1667
	shot 20 gts; Plug out
8/7	Top line 1655'
	sand 1660-66'
	TD. 1671'
	P.B. 1667
	shot 20 gts
	10 bbl oil
	Comp.

17 **KANSAS** Sec. 35 Twp. 23 R. 14

Well No. 2 Simpson
Kansan Oil Co Company

Contractor

FIRST REPORTS

SECTION PLAT

	0		

Ft. from N. Line

1120 Ft. from S. Line

1120 Ft. from E. Line

Ft. from W. Line

Location Machine

Rig up

Drilling and Remarks:

RECORD

Cased _____ in., _____ ft.

Sand _____

Gas _____

Oil _____

Total Depth _____

PRODUCTION

1st 24 hrs. Nat. _____

1st 24 hrs. after shot _____

Gas _____ Cu. Ft.

Dry Hole _____

Abandoned _____

Date

7/2

1929

CHAS. L. SHERWOOD

Scout

Workson

17 **KANSAS** Sec. 35 Twp. 23 R. 14

Well No. 2 *Simpson*

Kansan Oil Co Company

Contractor

COMPLETE**SECTION PLAT**

	0		

Ft. from N. Line

1170 Ft. from S. Line

1170 Ft. from E. Line

Ft. from W. Line

Location

Rig up

Drilling and Remarks:

T. Line 1655

PB to 1667

20/10 Blk.

RECORD

Cased _____ in., _____ ft.

Sand *1660-66*

Gas _____

Oil _____

Total Depth *1671***PRODUCTION**

1st 24 hrs. Nat. _____

1st 24 hrs. after shot _____

Gas _____ Cu. Ft.

Dry Hole _____

Abandoned _____

Date

AUG 7 1929

CHAS. L. SHERWOOD

19

Scout