

Section 36 Township 23 Range 11EWell No. #2 LightCompany Ed Ashlock

NORTH

	0						

WEST

EAST

SOUTH

Woodson

KANSAS

Sec. 36 Twp. 23 R. 14E

Well No. #2 Light Farm

Ed Ashlock Company

Barker Contractor


330 Ft. from N. Line

_____ Ft. from S. Line

_____ Ft. from E. Line

990 Ft. from W. Line

NE NW NW

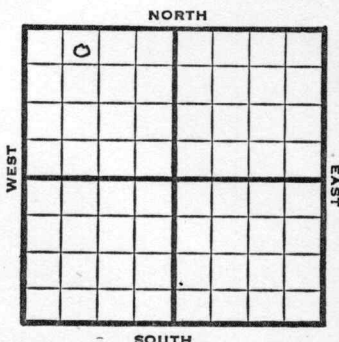

1952

Elev. -

REPORT

1/30 Spud 1-26-52
Drlg. 100'

2/6 Drlg. 784'

2/13 8" @ 840'
Drlg. 1612'

2/27 Spud 1-26-52
Oil well TD 1612' 10" @ 480
8" @ 840 Miss 1595' TD 1612'
FU 1000' oil 24 hr. 5" @ 1594'
1000 A
Comp. 15 BOPD

COMPLETED

County Woodson State Kansas
 Sec. 36 (Blk.) 23 (Sur.) 14E Map No.

Operator Ed Ashlock
 Well No. 2 Farm Light

Elev. _____ Location NE NW NW

0							

FIRST REPORT

330 Ft. From N Line NW

990 Ft. From W Line _____ Quarter _____

1st. Report JAN 30 1952

Completion _____

Remarks _____

Barker - Contr.

Spudding Date 1-26-52

Drlg. Data _____

Drlg. 100

J. G. McGEHEE

County Woodson State KansasSec. 36 (Blk.) 23 (Sur.) 14E Map No.Operator Ed AshlockWell No. 2 Farm LightElev. Location NE NW NW

0							

330 Ft. From N Line NW990 Ft. From W Line Quarter

1st. Report

Completion FEB 27 1952

Remarks

Barker - Contr.Spudding Date 1-26-52Drlg. Data Oil well TD 161210" @ 480 8" @ 840 Miss. 1595TD 1612 FU 1000' oil 24 hr. 5" @ 15941000 A Comp. 15 bopd