


Section 36 Township 23 Range 14E

Well No. #3 Light

Company Ed Ashlock

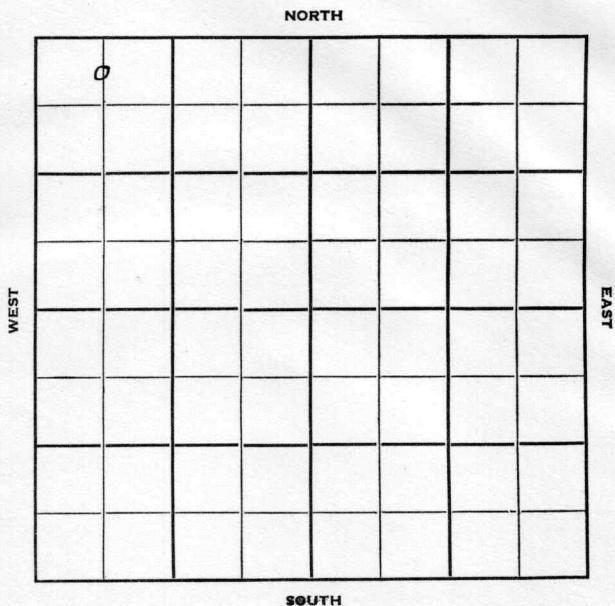

Woodson

KANSAS

Sec. 36 Twp. 23 R. 14E

Well No. #3 Light Farm

Ed Ashlock Company

C. H. Barker Contractor


330 Ft. from N. Line

_____ Ft. from S. Line

_____ Ft. from E. Line

660 Ft. from W. Line

C N L NW NW

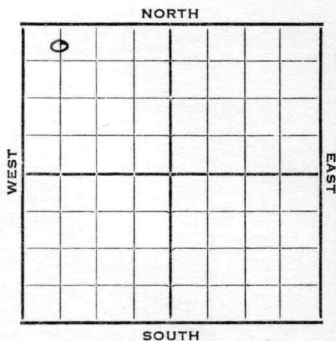

1952 Elev. - REPORT

4/30 R U S T

6/4 Spud 4-30-52
Oil Well TD 1643'
8" @ 225' 6" @ 933'
Miss. 1612' 5" @ 1620
TD 1643' Comp. 15 bopd

COMPLETED

County **Woodson** State **Kansas**Sec. **36** (Blk. Twp.) **23** (Sur. Rge.) **14E** Map No.Operator **Ed Ashlock**Well No. **3** Farm **Light**Elev. Location **C N L NW NW**

0					

330 Ft. From **N** Line **NW****660** Ft. From **W** Line Quarter1st. Report **APR 30 1952**

Completion


Remarks

C. H. Barker - Contr.

Spudding Date

Drlg. Data

R U S T**J. G. McGEHEE**

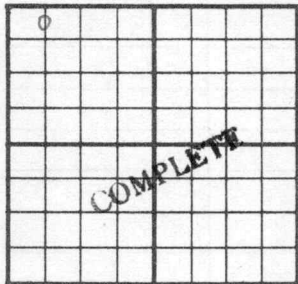County Woodson State KansasSec. 36 (Blk. 23 (Sur. 14E Map No.)
(Twp.) (Rge.)Operator Ed AshlockWell No. 3 Farm LightElev. Location C N L NW NW330 Ft. From N Line NW660 Ft. From W Line Quarter1st. Report Completion JUN 4 1952Remarks C.H. Barker - Contr.Spudding Date 4-30-52Drig. Data Oil well TD 16438" @ 225 6" @ 933 Miss. 16125" @ 1620 TD 1643 Comp. 15 bopd

J. G. McGEHEE