


Map No. _____ Sec. 21 Twp. 27 R. 4Well No. 16-Doster Farm _____The Man Company _____

NORTH

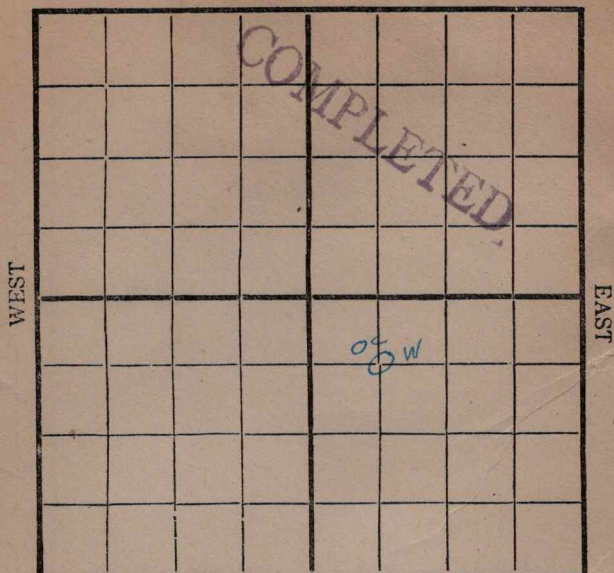

SOUTH

Location ✓ ✓ _____Rig Up 1916 _____

Drilling Remarks:

Drilling Remarks:

200 = 11/20700 = 11/27 = 12/41305 = 12/111650 = 12/181860 = 12/282185 = 1/8/17

RECORD

PRODUCTION

Cased _____ in _____ Ft.

1st 24 hrs. Nat. _____

Sand _____

1st 24 hrs. after shot _____

Gas _____

Gas _____ Cu. Ft.

Oil _____

Dry Hole _____

Total Depth _____


Abandoned _____

Map No. _____ Sec. 21 Twp. 27 R. 4
 Well No. 16 Farm _____
W. A. W. W. Company

NORTH

WEST

EAST

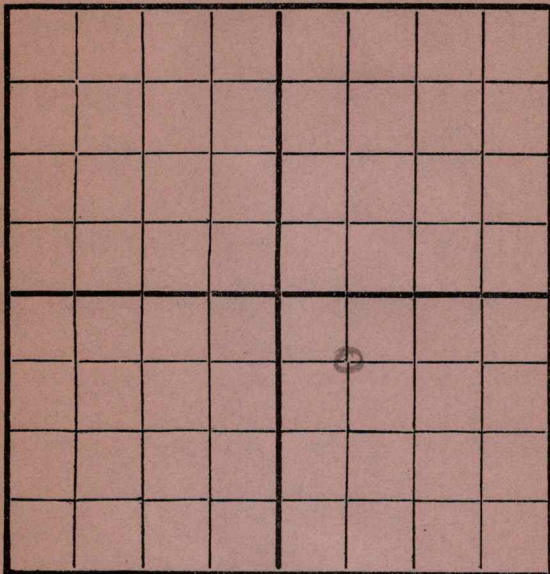

SOUTH

Location _____
 Rig Up _____
 Drilling and remarks

700

RECORD

Cased _____ in. _____ Ft.
 Sand _____
 Gas _____
 Oil _____
 Total Depth _____

PRODUCTION

1st 24 hrs. Nat. _____
 1st 24 hrs. after shot _____
 Gas _____ Cu. Ft.
 Dry Hole _____
 Abandoned _____

Date


11/27 1916

C. W. W. Scout

Map No. _____ Sec. 21 Twp. 27 R. 4
 Well No. 16 _____ Farm _____
 _____ Company _____

NORTH

WEST

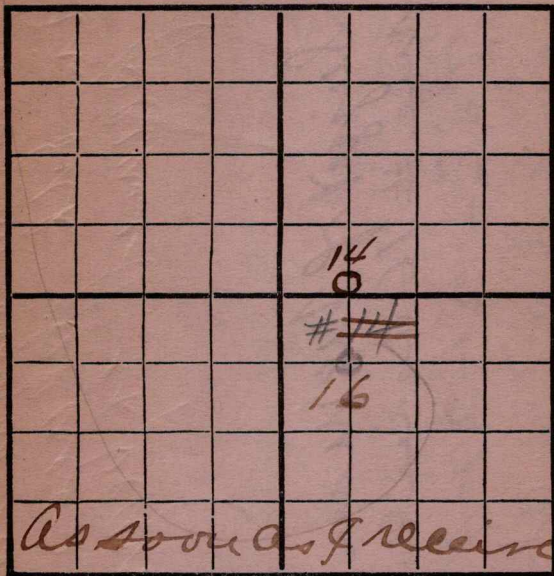

EAST

SOUTH

Location _____
 Rig Up _____
 Drilling and remarks _____

RECORD

Cased _____ in. _____ Ft.
 Sand _____
 Gas _____
 Oil _____
 Total Depth _____

PRODUCTION

1st 24 hrs. Nat. _____
 First 24 hrs. after shot _____
 Gas _____ Cu. Ft.
 Dry Hole _____
 Abandoned _____


Date

11/14, 1916 Carly Scout

Map No. _____ Sec. 21 Twp. 27 R. 4Well No. 16 Foster Farm __________McWane Company _____

NORTH

WEST

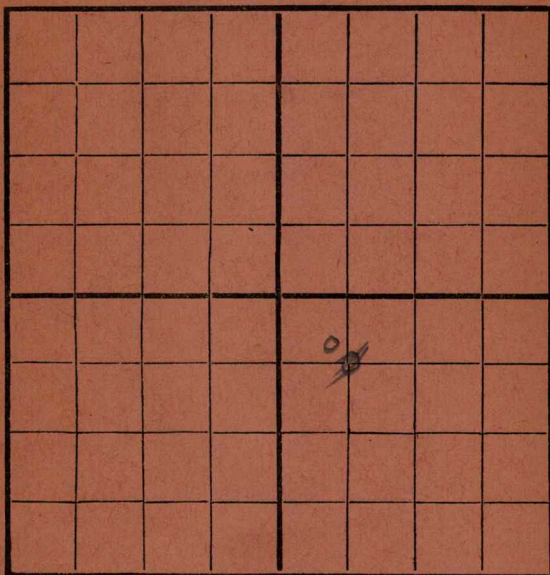

EAST

SOUTH

Location Changed

Rig Up _____

Drilling and remarks _____

RECORD

Cased _____ in. _____ Ft.

Sand _____

Gas _____

Oil _____

Total Depth _____

PRODUCTION

1st 24 hrs. Nat. _____

1st 24 hrs. after shot _____

Gas _____ Cu. Ft.

Dry Hole _____

Abandoned _____

Date


12/2, 1916, C. C. C. C. Scout

Map No. _____ Sec. 21 Twp. 27 R. 4
 Well No. 16 Foster Farm _____
McMan Company _____

NORTH

WEST

EAST

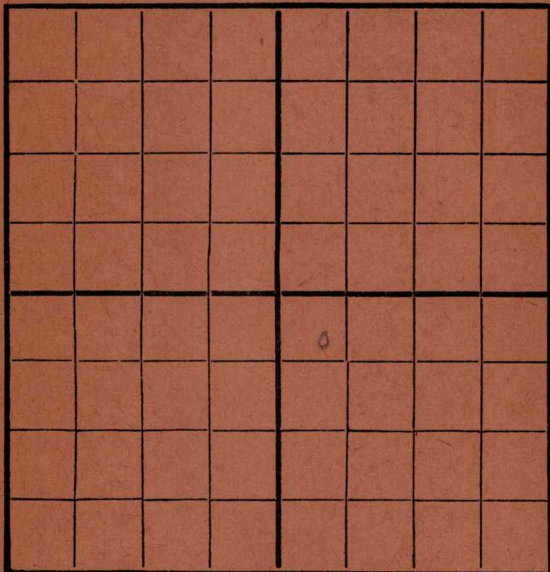

SOUTH

Location _____
 Rig Up _____
 Drilling and remarks _____

700

RECORD

Cased _____ in. _____ Ft.
 Sand _____
 Gas _____
 Oil _____
 Total Depth _____

PRODUCTION

1st 24 hrs. Nat. _____
 1st 24 hrs. after shot _____
 Gas _____ Cu. Ft.
 Dry Hole _____
 Abandoned _____


Date

12/4, 1916, Cordell Scout

Map No. _____ Sec. 21 Twp. 27 R. 4
 Well No. 16 Foster Farm _____
McKinn Company _____

NORTH

WEST

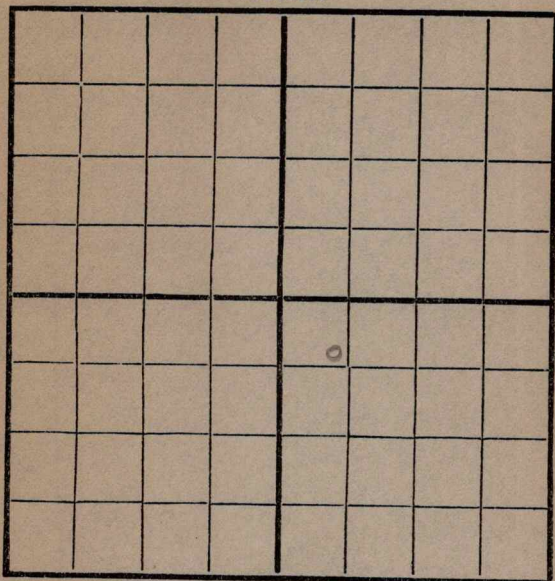

EAST

SOUTH

Location _____

Rig Up _____

Drilling and remarks

1305

RECORD

Cased _____ in. _____ Ft.

Sand _____

Gas _____

Oil _____

Total Depth _____

PRODUCTION

1st 24 hrs. Nat. _____

1st 24 hrs. after shot _____

Gas _____ Cu. Ft.

Dry Hole _____

Abandoned _____

Date


12/11, 1916, Cordell Scout

Map No. _____ Sec. 21 Twp. 27 R. 4
 Well No. 16 Foster Farm _____
McWane Company _____

NORTH

WEST

EAST

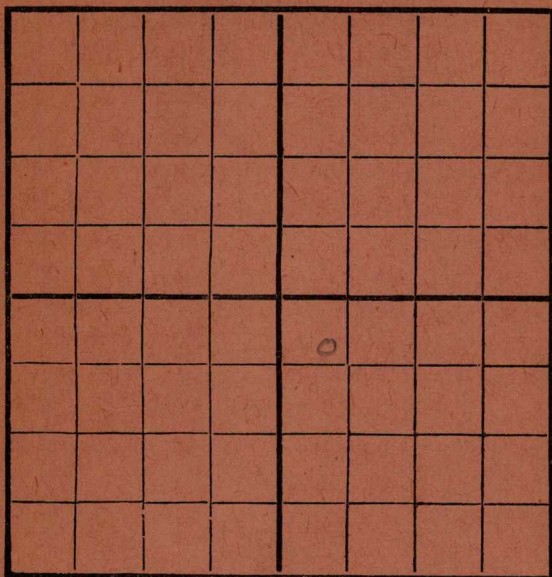

SOUTH

Location _____
 Rig Up _____
 Drilling and remarks _____

1650'

RECORD

Cased _____ in. _____ Ft.
 Sand _____
 Gas _____
 Oil _____
 Total Depth _____

PRODUCTION

1st 24 hrs. Nat. _____
 1st 24 hrs. after shot _____
 Gas _____ Cu. Ft.
 Dry Hole _____
 Abandoned _____


Date

12/18, 1916 C. Condit Scout

Map No. _____ Sec. 21 Twp. 27 R. 4

Well No. 16 Foster Farm _____

M. C. Wilson Company _____

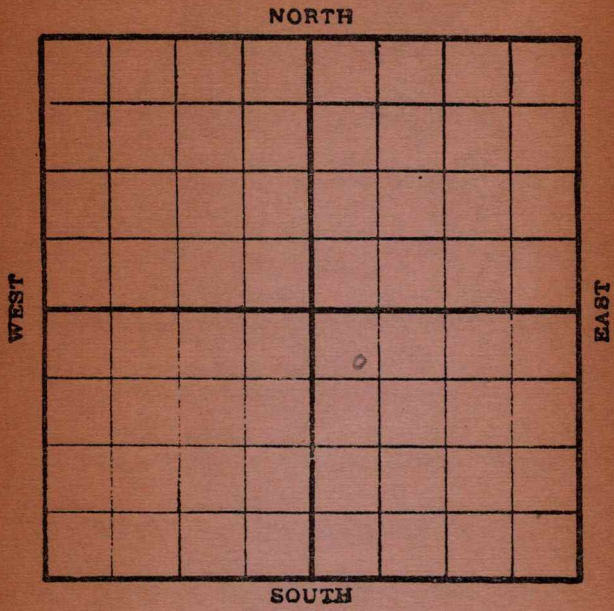

Location _____
 Rig up _____
 Drilling and remarks:

1860

RECORD

Cased _____ in. _____ Ft.
 Sand _____
 Gas _____
 Oil _____
 Total Depth _____

PRODUCTION

1st. 24 hrs. Nat. _____
 1st. 24 hrs. after shot _____
 Gas _____ Cu. Ft.
 Dry Hole _____
 Abandoned _____

Date


12/28/6 C. C. C. C. Scout

Map No. _____ Sec. 21 Twp. 27 R. 4
 Well No. 16 Foster Farm _____
McNamee Company _____

NORTH

WEST

EAST

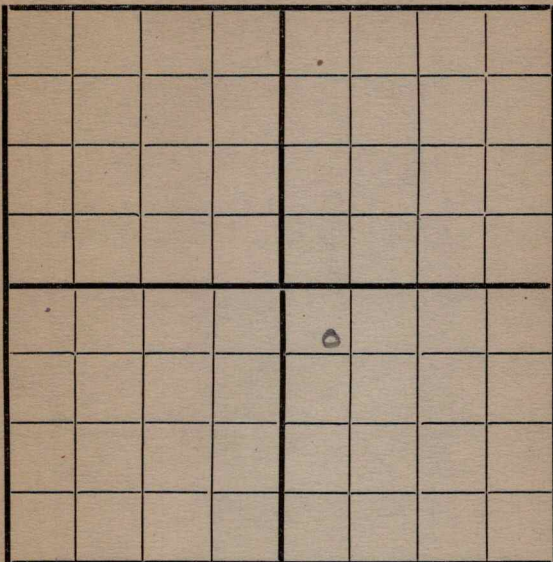

SOUTH

Location _____

Rig Up _____

Drilling and remarks

2005

RECORD

Cased _____ in. _____ Ft.

Sand _____

Gas _____

Oil _____

Total Depth _____

PRODUCTION

1st 24 hrs. Nat. _____

1st 24 hrs. after shot _____

Gas _____ Cu. Ft.

Dry Hole _____


Abandoned _____

Date

1/1, 1917 Condy Scout

Map No. _____ Sec. 21 Twp. 27 R. 4
 Well No. 16 Foster Farm _____
McMan Company _____

NORTH

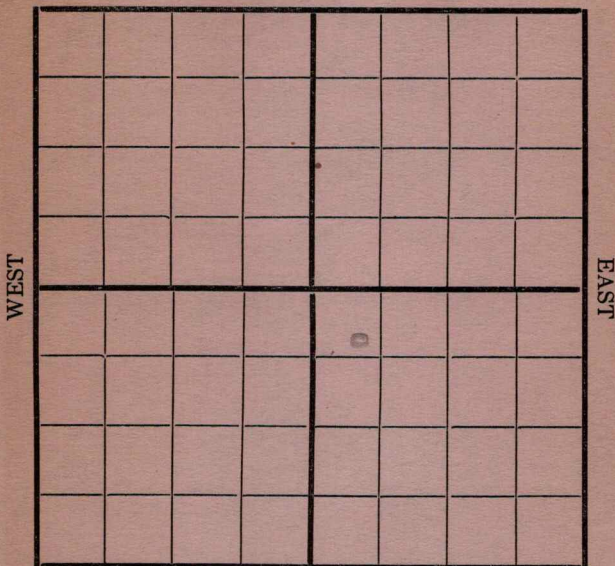

SOUTH

Location _____
 Rig Up _____
 Drilling and remarks

2185

RECORD

Cased _____ in. _____ Ft.
 Sand _____
 Gas _____
 Oil _____
 Total Depth _____

PRODUCTION

1st 24 hrs. Nat. _____
 1st 24 hrs. after shot _____
 Gas _____ Cu. Ft.
 Dry Hole _____
 Abandoned _____

Date

1/8, 1917 Early Scout

Map No. _____ Sec. 21 Twp. 27 R. 4
Well No. 16 Foster _____ Farm
Geo. Moore _____ Company

NORTH

WEST

EAST

SOUTH

Location _____

Rig Up-----

Drilling and remarks

206

RECORD

Cased-----in. -----Ft.

Sand_ _ _ _ _

Gas_____

Oil _____

Total Depth_____

PRODUCTION

1st 24 hrs. Nat.

1st 24 hrs. after shot-----

Gas----- Cu. Ft.

Dry Hole_____

Abandoned _____


Date _____

11/20, 1916 *Condit* Scout

Map No. _____ Sec. 21 Twp. 22 R. 4
 Well No. 16 Foster Farm _____
McNamee Company

NORTH

WEST

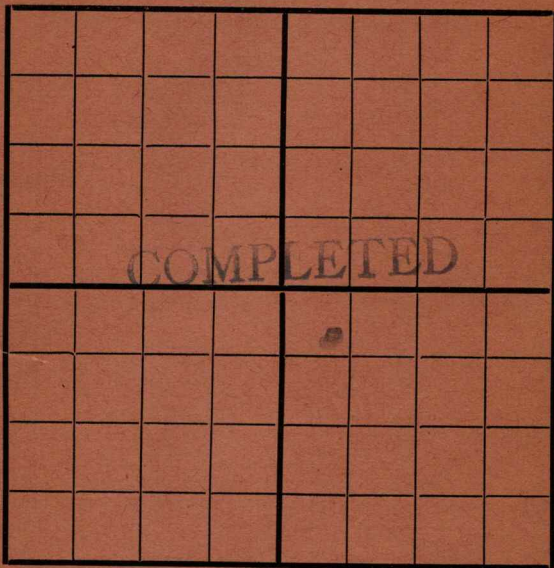

EAST

SOUTH

Location _____
 Rig Up _____
 Drilling and remarks _____

Est at
480 0 Bbls

RECORD

Cased _____ in. _____ Ft.
 Sand 2326 - 2328
 Gas _____
 Oil _____
 Total Depth _____

PRODUCTION

1st 24 hrs. Nat. _____
 1st 24 hrs. after shot _____
 Gas _____ Cu. Ft.
 Dry Hole _____
 Abandoned _____

Date

1/15, 1919 _____ Scout