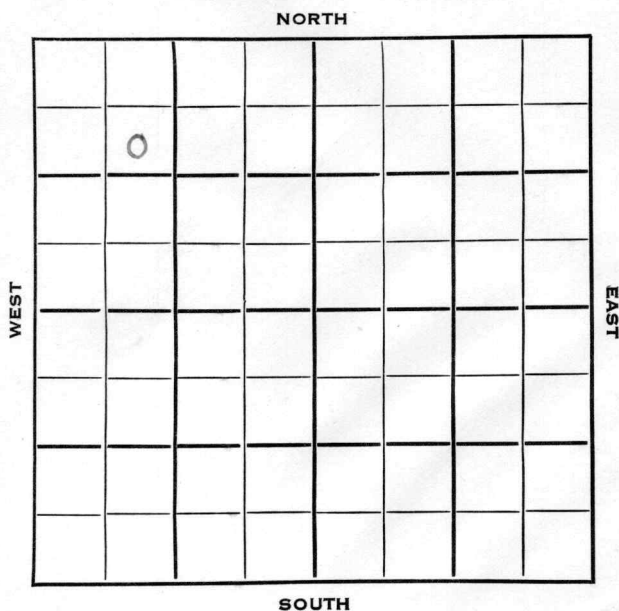


Section 36 Township 23 Range 11EWell No. #5 LightCompany J.W. Gaddy

Woodson KANSAS ✓

Sec. 36 Twp. 23 R. 14E

Well No. #5 Light Farm

J. W. Gaddy Company


Chas. Barker Contractor

990 Ft. from N. Line

 Ft. from S. Line

 Ft. from E. Line

990 Ft. from W. Line

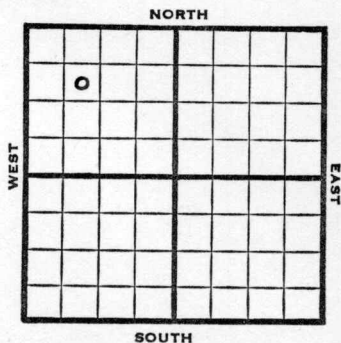

SE NW NW (TWIN WELL)

1953 Elev. - REPORT

4/29 RUCT

7/1 Spud 4-29-53
Oil Well
TD 1618
8" @ 975
Miss 1612
5" @ 1612
TD 1612
DD 1618, FU 700' fluid, 1000A
Comp. 18 bopd 20 bw

County Woodson State Kanss
 Sec. 36 (Blk.) 23 (Sur.) 14E Map No.
 Operator J. W. Gaddy
 Well No. 5 Farm Light
 Elev. _____ Location SE NW NW (twin well)

990 Ft. From N Line NW
990 Ft. From W Line Quarter
 1st. Report APR 29 1953
 Completion _____
 Remarks _____
Chas. Barker - Contr.
 Spudding Date _____

Drlg. Data _____

R U C T

J. G. McGEHEE

County Woodson State Kansas
 Sec. 36 (Blk.) 23 (Sur.) 14E Map No. _____
 Operator J. W. Gaddy
 Well No. 5 Farm Light
 Elev. _____ Location SE NW NW (twin well)

	0						

990 Ft. From N Line NW
 990 Ft. From W Line Quarter

1st. Report

Completion JUL 1 1953

Remarks

Chas. Barker - Contr.

Spudding Date 4-29-53

Drlg. Data Oil well TD 1618

8" @ 975 Miss. 1612 5" @ 1612

TD 1612 DD 1618 FU 700' fluid

1000 A Comp. 18 bopd 20 bw