


Section 36 Township 23 Range 14E

Well No. #1 F. L. Light

Company Ed Ashlook

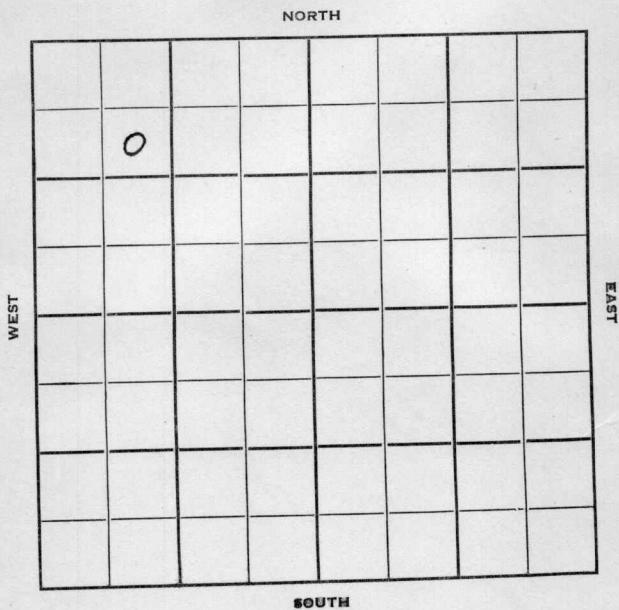

Woodson

KANSAS

Sec. 36 Twp. 23 R. 14E ✓

Well No. #1 F. L. Light Farm

Ed Ashlook Company

Contractor


990' Ft. from N. Line

Ft. from S. Line

Ft. from E. Line

990' Ft. from W. Line

SE NW NW

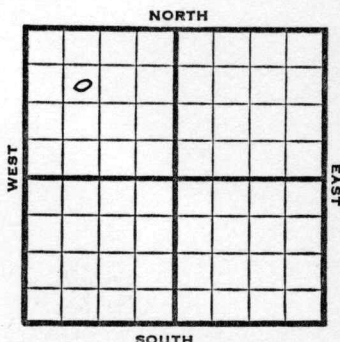

1951

Elev. -

REPORT

10/17

Spud 10-15-51
Drlg. 120'

11/28

Spud 10-15-51
Oil Well TD 1645
10" @ 870
Miss 1622 5" @ 1633
TD 1645 2000 A
Comp. 15 bopd

COMPLETED

County Woodson State KansasSec. 36 (Blk.) 23 (Sur.) 14E Map No.
(Twp.) (Rge.)Operator Ed AshlockWell No. 1 Farm F. L. LightElev. Location SE NW NW

FIRST REPORT

990 Ft. From N Line NW990 Ft. From W Line Quarter1st. Report OCT 17 1951

Completion

Remarks


Spudding Date 10-15-51

Drlg. Data

Drlg. 120

J. E. TYRA

County **Woodson** State **Kansas**
 Sec. **36** (Blk.) **23** (Sur.) **14E** Map No.
 Operator **Ed Ashlock**
 Well No. **1** Farm **F. L. Light**
 Elev. Location **SE NW NW**

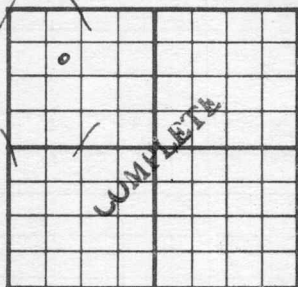

990 Ft. From **N** Line **NW**
 990 Ft. From **W** Line **Quarter**

1st. Report

Completion **NOV 28 1951**

Remarks

Spudding Date **10-15-51**

Drlg. Data **Oil well** **TD 1645**
10" @ 870 **Miss. 1622** **5" @ 1633**
TD 1645 **2000 A** **Comp. 15 bopd**