


Section 36 Township 23 Range 11E

Well No. #5 Whiteford

Company Ed Ashlock

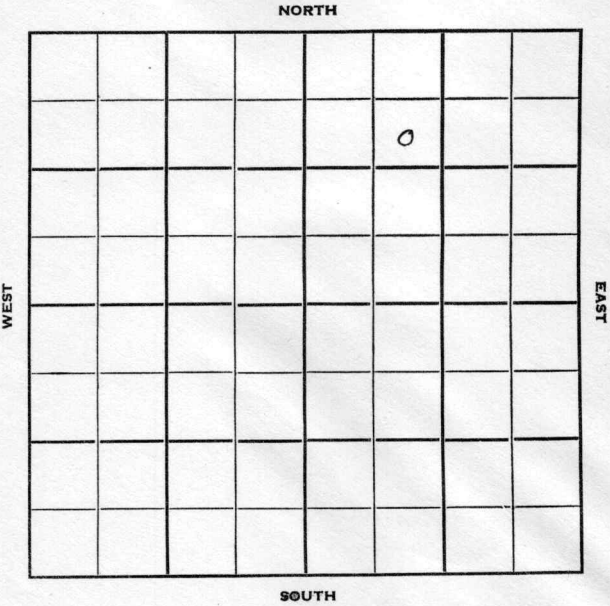

Woodson

KANSAS

Sec. 36 Twp. 23 R. 14E

Well No. #5 Whiteford Farm

Ed Ashlock Company

Contractor


990' Ft. from N. Line

Ft. from S. Line

Ft. from E. Line

990' Ft. from W. Line

SE NW NE

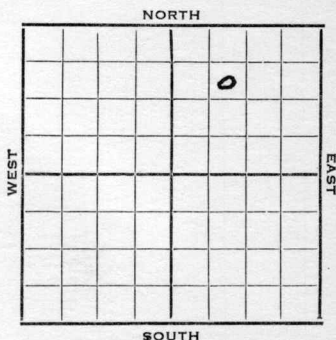

1952

REPORT

7/23

Location

7/30

Miss. 1580' TD 1612'

D&A

ABANDONED

County

State **Kansas**

Sec.

36

(Blk.)
(Twp.)

23

(Sur.)
(Rge.)

14E

Map No.

Operator

Ed Ashlock

Well No.

5

Farm

White ford

Elev.

Location

SE NW NE

0

FIRST REPORT

990

Ft. From

II

Line

NE

990

Ft. From

W

Line

Quarter

1st. Report

444

2 3

1952

Completion

Remarks

Spudding Date

Drlg. Data

J. G. McGEHEE

County Woodson State KansasSec. 36 (Blk.
Twp.) 23 (Sur.
Rge.) 14E Map No.Operator Ed AshlockWell No. 5 Farm WhitefordElev. Location SE NW NE990 Ft. From N Line NE990 Ft. From W Line Quarter

1st. Report

Completion JUL 30 1952

Remarks

Spudding Date

Drlg. Data

Miss. 1580 TD 1612 D & A

J. G. McGEHEE