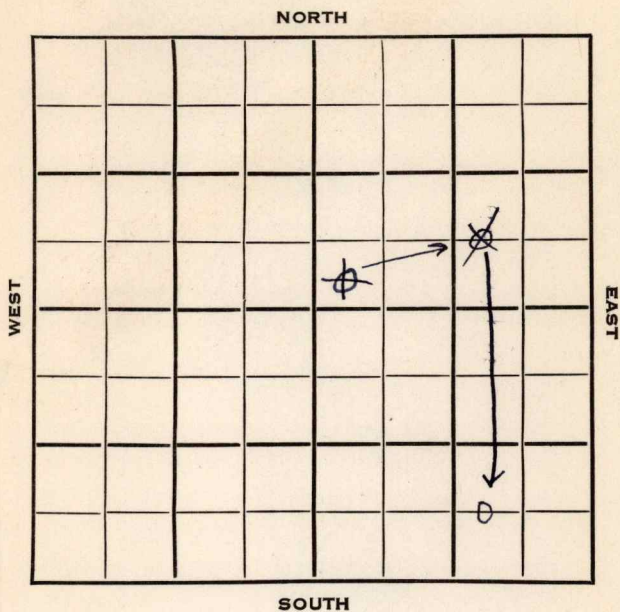


Section 23 Township 24 Range 9EWell No. #4 AgardCompany W.C. Perham

SEC.	23	TWP.	24	R.	9E
------	----	------	----	----	----

WELL NO.

#4 Agard

FARM

COMPANY

W.C. Perham

CONTRACTOR

Sunflower Drlg.

Thrall-Agard Pool

Ft. from N. Line

330 660

Ft. from S. Line


990

Ft. from E. Line

330

Ft. from W. Line

SE SE
CWL SE NE
SW SW NE

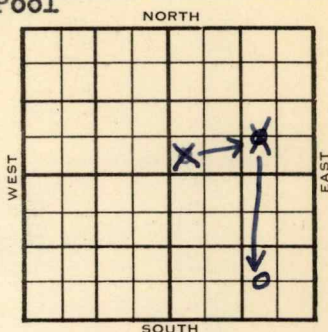

1953

ELEVATION

REPORT

9/23

Spud 9-19-53

8" @ 40'

Drlg 660'

10/28

Spud 9-19-53

Oil well TD 2260

8" @ 40'

Bart. 2245 TD 2260

5" @ 2247 CO to 2259 sd-Oil-frac.

P/4 BOPH 10 hr. Comp. 25 BOPD

COMPLETED

County Greenwood State KansasSec. 23 (Blk.) 24 (Sur. Rge.) 9E Map No.Operator W. C. PerhamWell No. 4 Farm AgardElev. Location SW SW NE

FIRST REPORT

330 Ft. From S Line NE330 Ft. From W Line Quarter1st. Report SEP 23 1953

Completion

Remarks

Sunflower Drlg. - Contr.Spudding Date 9-19-53Drlg. Data Thrall-Agard Pool8" @ 40 drlg. 660

J. G. McGEHEE

Kansas

Map No. _____ Sec. 23 Twp. 24 R. 9EWell No. 4 Agard

W. C. Perham _____ Company

CORRECTION

Contractor

C W L SE NE

SECTION PLAT

			•

_____ Ft. from N. Line

660 Ft. from S. Line990 Ft. from E. Line

_____ Ft. from W. Line

Greenwood County

Location _____

Rig up _____

Drilling and Remarks:

Reported

SW SW NE

*also change
co name*

RECORD

Cased _____ in., _____ ft.

Sand _____

Gas _____

Oil _____

Total Depth _____

PRODUCTION

1st 24 hrs. Nat. _____

1st 24 hrs. after shot _____

Gas _____ Cu. Ft.

Dry Hole _____

Abandoned _____

Date

EP 30 1952

J. G. McGEHEE

Scout

Map No. _____ Sec. 23 Twp. 24 R. 9EWell No. 4 Agard

W. C. Perham

Company

CORRECTION

Contractor


C W L SE SE

SECTION PLAT

_____ Ft. from N. Line

660 Ft. from S. Line990 Ft. from E. Line

_____ Ft. from W. Line

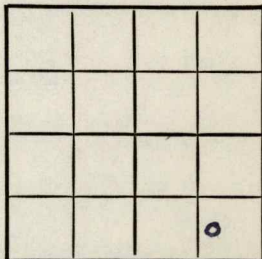

Greenwood County

Location _____

Rig up _____

Drilling and Remarks:

Reported

C W L SE NE

RECORD

Cased _____ in., _____ ft.

Sand _____

Gas _____

Oil _____

Total Depth _____

PRODUCTION

1st 24 hrs. Nat. _____

1st 24 hrs. after shot _____

Gas _____ Cu. Ft.

Dry Hole _____

Abandoned _____

Date

OCT 14 1953

19

J. G. McGEHEE

Scout

County Greenwood State Kansas
 Sec. 23 (Blk.) 24 (Sur.) 9E Map No.
 Operator W. C. Perham
 Well No. 4 Farm Agard
 Elev. Location C W L SE SE



660 Ft. From S Line SE
990 Ft. From E Line Quarter
 1st. Report
 Completion OCT 28 1953
 Remarks Thrall-Agard Pool
Sunflower Drlg. - Contr.
 Spudding Date 9-19-53

Drlg. Data Oil well TD 2260
8" @ 40 Bart. 2245 TD 2260
5" @ 2247 CO to 2259 sd-oil-frac
P/ 4 boph 10 hr. Comp. 25 bopd