

Woodson

Form 51-5M-2-29-34703

Map No.

KANSAS

Sec.

31

Twp.

23

R.

14E

Well No.

1- Shaffer
Nye & Kilby

Farm

Company

NORTH

WEST

EAST

SOUTH

Location

Drilling Remarks

Rig Up

Drilling Remarks

RECORD

Cased in. ft.

Sand

Gas

Oil

Total Depth

PRODUCTION

1st 24 hrs. Nat.

1st 24 hrs. after shot

Gas cu. ft.

Dry Hole

Abandoned

Map No. **KANSAS** Sec. 31 Twp. 23 R. 14E


Well No. 1- Shaffer Farm
Nye & Kirby Company

 Ft. from N. Line

200 Ft. from S. Line

200 Ft. from E. Line

 Ft. from W. Line

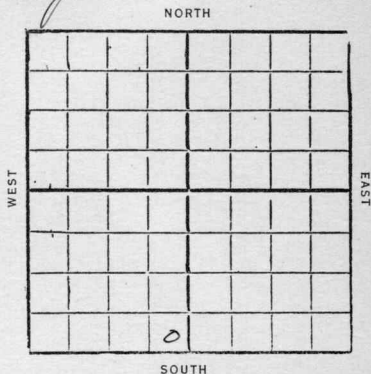

1932

Date	REPORT
5/25	Drill 830'
6/11	Land 1560-67 7,300,000 cu ft gas and show oil Well deepen
6/8	TD 1578 flow 30 bbl first hr
6/15	TD 1578 flow 250 bbl 12 hrs
6/22	TD 1578 flows 10 bbl per hr perched in
6/29	TD 1578 flow 186 bbl oil and 65 bbl water
7/6	Land 1560-83 TD 1583 flow 100 bbl oil and 65 bbl water 24 hr 7 M gas Comp

17 KANSAS *Noodin*
 Map No. _____ Sec. *31* Twp. *23* R. *14* ^E

Well No. *1* *Shaffer*
Nye *Kilby* Company
 Contractor

FIRST REPORTS

_____ Ft. from N. Line

700 Ft. from S. Line

700 Ft. from E. Line

_____ Ft. from W. Line

SECTION PLAT

Location _____

Rig up _____

Drilling and Remarks:

blg 830'

RECORD

Cased _____ in., _____ ft.

Sand _____

Gas _____

Oil _____

Total Depth _____

PRODUCTION

1st 24 hrs. Nat. _____

1st 24 hrs. after shot _____

Gas _____ Cu. Ft.

Dry Hole _____

Abandoned _____

Date

MAY 25 1932

192

CHAS. L. SHERWOOD

Scout

17 KANSAS

Map No. _____ Sec. 31 Twp. 23 R. 14 E

Well No. 1 Shayer

Nye & Kilby _____ Company

Contractor

COMPLETED

SECTION PLAT

Ft. from N. Line

700 Ft. from S. Line

700 Ft. from E. Line

Ft. from W. Line

Location _____

Rig up _____

Drilling and Remarks:

Flow 100 Bls/hr
 & 65 Bls/hr
 24 Hrs.

RECORD

Cased _____ in., _____ ft.

Sand 1560-1583

Gas _____

Oil _____

Total Depth 1583

PRODUCTION

1st 24 hrs. Nat. _____

1st 24 hrs. after shot _____

Gas 7 1/4 Cu. Ft.

Dry Hole _____

Abandoned _____

Date

JUL 6 1932 CHAS. L. SHERWOOD

192 _____ Scout